

HANCOCK
K 443

MISSISSIPPI DEPARTMENT OF NATURAL RESOURCES
Bureau of Land and Water Resources
Southport Mall
P.O. Box 10631
Jackson, Mississippi 39209
WATER WELL DRILLERS LOG

CODED

May 12 1986 Ward Well Dlg Hancock
date well completed firm name county well located

LANDOWNER: George Rowan
Sargon Dr.
Bay St. Louis, ms.
(mailing address)


WELL LOCATION:
sec. 22 T. 9 N R. 14 W
5 miles N/W of B.S.L.
(distance) (direction) (nearest town)

WELL PURPOSE: Home
(home, irrigation, municipal, industrial)

- WELL COMPLETION DATA:
- (1) diameter (inches) 2"
 - (2) total depth (feet) 405
 - (3) static water level (feet) 1 below top of ground.
 - (4) casing PVC, 385,
(material) (depth)
- if telescope see back.
(size)
 - (5) screen 20', -
(length) (depth to top)
2", PVC
(size) (material)
 - (6) pump crane, -
(HP) (yield gpm)
- (type power)
 - (7) electric log NO
(yes or no)
N/A
(organization running log)
 - (8) how well bottom plugged BWU

description of formations encountered	from	to
<u>fill sd</u>	<u>0</u>	<u>2</u>
<u>clay</u>	<u>2</u>	<u>18</u>
<u>sd</u>	<u>18</u>	<u>45</u>
<u>clay</u>	<u>45</u>	<u>96</u>
<u>fine sd</u>	<u>96</u>	<u>115</u>
<u>clay-silt</u>	<u>115</u>	<u>152</u>
<u>fine sd</u>	<u>152</u>	<u>176</u>
<u>clay-silt</u>	<u>176</u>	<u>265</u>
<u>fine sd</u>	<u>265</u>	<u>294</u>
<u>clay-silt</u>	<u>294</u>	<u>375</u>
<u>crk sd</u>	<u>375</u>	<u>405</u>

CODED

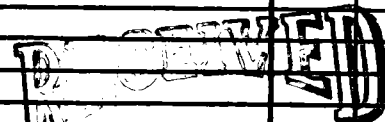


MAY 19 7 1986

Department of Natural Resources
Bureau of Land & Water Resources

DRILLERS REMARKS: N/A

If well telescopes please sketch and show depths.

GROUND LEVEL

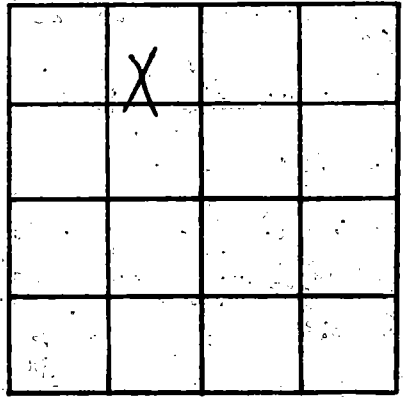

SECTION 22

Please indicate well location X.

ADDITIONAL INFORMATION

If more than one screen, show locations of each on sketch.