

MISSISSIPPI DEPARTMENT OF NATURAL RESOURCES

Bureau of Land and Water Resources

Southport Mall

P.O. Box 10631

Jackson, Mississippi 39209

WATER WELL DRILLERS LOG

Hancock  
X 444

CODED

June 23 1986 Ward Well Drg Hancock  
date well completed firm name county well located

LANDOWNER: John Bolton Construction  
N. Beach Road  
Bay St. Louis, Miss.  
(mailing address)

WELL LOCATION:  
sec. 37 T. 9 N. R. 14 E.  
4 miles N/W of B.S.L.  
(distance) (direction) (nearest town)

WELL PURPOSE: Home  
(home, irrigation, municipal, industrial)

- WELL COMPLETION DATA:
- (1) diameter (inches) 2"
  - (2) total depth (feet) 357
  - (3) static water level (feet) 4 <sup>below</sup> <sub>above</sub> top of ground.
  - (4) casing PVC, 337,  
(material) (depth)  
- if telescope see back.  
(size)
  - (5) screen 20', -  
(length) (depth to top)  
2", PVC  
(size) (material)
  - (6) pump none, -  
(HP) (yield gpm)  
-  
(type power)
  - (7) electric log NO  
(yes or no)  
N/A  
(organization running log)
  - (8) how well bottom plugged BWV

description of formations encountered	from	to
<u>Sandy Soil</u>	<u>0</u>	<u>3</u>
<u>Clay</u>	<u>3</u>	<u>16</u>
<u>SD</u>	<u>16</u>	<u>38</u>
<u>Clay</u>	<u>38</u>	<u>85</u>
<u>Red Mottled SC</u>	<u>85</u>	<u>140</u>
<u>Clay-silt</u>	<u>140</u>	<u>295</u>
<u>Coal S</u>	<u>295</u>	<u>357</u>

CODED

RECEIVED


AUG 4 1986

Department of Natural Resources  
Bureau of Land & Water Resources

DRILLERS REMARKS: N/A

If well telescopes please sketch and show depths.

GROUND LEVEL

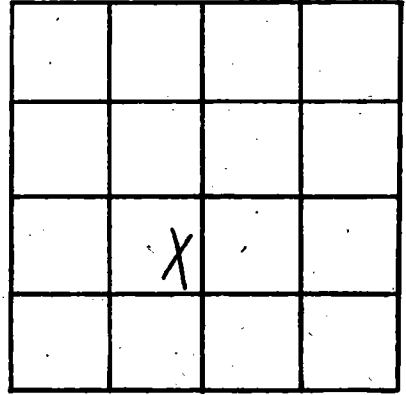

SECTION 37

Please indicate well location X.

ADDITIONAL INFORMATION

If more than one screen,  
show locations of each on sketch.