

MISSISSIPPI DEPARTMENT OF NATURAL RESOURCES

Bureau of Land and Water Resources

Southport Mall

P.O. Box 10631

Jackson, Mississippi 39209

WATER WELL DRILLERS LOG

Hancock
K445

CODED

May 30 1986 Wood Well Dly Hancock
date well completed firm name county well located

LANDOWNER: Elvira Welch
Lin & Deer St.
Bay St. Louis, Mo.
(mailing address)

WELL LOCATION:
sec. 27 T. 8 N. R. 14 E.
4 miles N/W of Bay St. Louis
(distance) (direction) (nearest town)

WELL PURPOSE: Home
(home, irrigation, municipal, industrial)

WELL COMPLETION DATA:

(1) diameter (inches) 2"

(2) total depth (feet) 336

(3) static water level (feet) 1 below top of ground. (above)

(4) casing PVC, 316,
(material) (depth)
- If telescope see back.
(size)

(5) screen 20', -
(length) (depth to top)
2", PVC
(size) (material)

(6) pump owner, -
(HP) (yield gpm)
-
(type power)

(7) electric log NO
(yes or no)
N/A
(organization running log)

(8) how well bottom plugged BWV

description of formations encountered	from	to
<u>clay</u>	<u>0</u>	<u>15</u>
<u>SD</u>	<u>15</u>	<u>47</u>
<u>clay</u>	<u>47</u>	<u>105</u>
<u>Fine SD</u>	<u>105</u>	<u>116</u>
<u>clay - Silt</u>	<u>116</u>	<u>152</u>
<u>Fine SD</u>	<u>152</u>	<u>168</u>
<u>clay</u>	<u>168</u>	<u>285</u>
<u>SD</u>	<u>285</u>	<u>336</u>

CODED

RECEIVED


AUG 4 1986

Department of Natural Resources
Bureau of Land & Water Resources

DRILLERS REMARKS: N/A

If well telescopes please sketch and show depths.

GROUND LEVEL

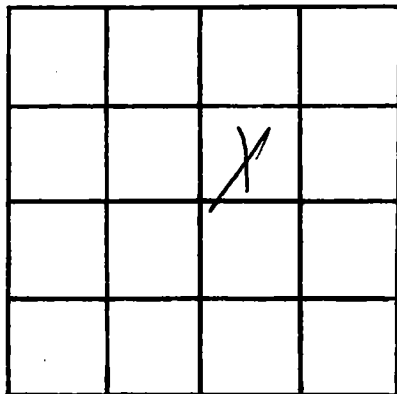

SECTION 27

Please indicate well location X.

ADDITIONAL INFORMATION

If more than one screen,
show locations of each on sketch.