

MISSISSIPPI DEPARTMENT OF NATURAL RESOURCES

Bureau of Land and Water Resources

Southport Mall

P.O. Box 10631

Jackson, Mississippi 39209

WATER WELL DRILLERS LOG

Hancock
K 446

CODED

June 19 1986 Ward Well Drly Hancock
 date well completed firm name county well located

LANDOWNER: Francis Ray
Stewart Drive
Box St. Louis, Mo.
 (mailing address)

WELL LOCATION:
 sec. 42 T. 8 N. R. 14 E.
8 miles N/W of B.S.L.
 (distance) (direction) (nearest town)

WELL PURPOSE: Home
 (home, irrigation, municipal, industrial)

WELL COMPLETION DATA:

(1) diameter (inches) 2"

(2) total depth (feet) 546

(3) static water level (feet) 5 below above
 top of ground.

(4) casing PVC, 526,
 (material) (depth)
- if telescope see back.
 (size)

(5) screen 20', -
 (length) (depth to top)
2", PVC
 (size) (material)

(6) pump Ornu -
 (HP) (yield gpm)
-
 (type power)

(7) electric log NO
 (yes or no)
N/A
 (organization running log)

(8) how well bottom plugged BWV

description of formations encountered	from	to
Fill - clay	0	21
sd	21	35
clay	35	82
Red sand - sd	82	96
clay	96	105
sd	105	126
clay - silt	126	391
sd	391	420
clay - silt	420	505
Coarse sd	505	546

CODED


RECEIVED
 AUG 4 1986

Department of Natural Resources
 Bureau of Land & Water Resources

DRILLERS REMARKS: N/A

If well telescopes please sketch and show depths.

GROUND LEVEL

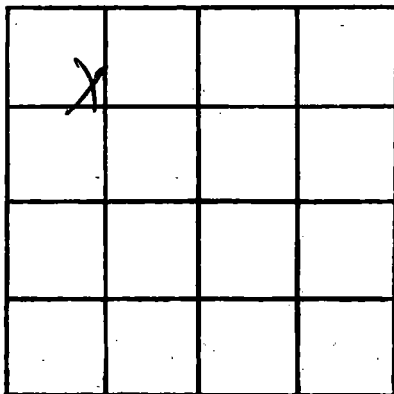

SECTION 42

Please indicate well location X.

ADDITIONAL INFORMATION

If more than one screen, show locations of each on sketch.