

MISSISSIPPI DEPARTMENT OF NATURAL RESOURCES
Bureau of Land and Water Resources
 Southport Mall
 P.O. Box 10631
 Jackson, Mississippi 39209
WATER WELL DRILLERS LOG

CODED

HANCOCK
K447

May 22 1986 Ward Well Dly Hancock
 date well completed firm name county well located

LANDOWNER: St. Anne Catholic Church
P.O. Box 37
Clermont Harbor ms.
 (mailing address)

WELL LOCATION:
 sec. 8 T. 9 N R. 14 E
6 miles S/W of Waveland
 (distance) (direction) (nearest town)

WELL PURPOSE: Home
 (home, irrigation, municipal, industrial)

- WELL COMPLETION DATA:
- (1) diameter (inches) 2"
- (2) total depth (feet) 315
- (3) static water level (feet) 12 ^{below} above top of ground.
- (4) casing PVC 305
 (material) (depth)
 (size) If telescope see back.
- (5) screen 10' -
 (length) (depth to top)
2" PVC
 (size) (material)
- (6) pump Diener -
 (HP) (yield gpm)
 (type power)
- (7) electric log NO
 (yes or no)
N/A
 (organization running log)
- (8) how well bottom plugged BWU

description of formations encountered	from	to
<u>fill - clay</u>	<u>0</u>	<u>12</u>
<u>SC</u>	<u>12</u>	<u>14</u>
<u>clay</u>	<u>14</u>	<u>18</u>
<u>SC</u>	<u>18</u>	<u>47</u>
<u>clay w/ shell</u>	<u>47</u>	<u>92</u>
<u>Red Shell - SC</u>	<u>92</u>	<u>115</u>
<u>clay - silt</u>	<u>115</u>	<u>272</u>
<u>Coal SC</u>	<u>272</u>	<u>315</u>

CODED


RECEIVED
 AUG 4 1986

Department of Natural Resources
 Bureau of Land & Water Resources

DRILLERS REMARKS: N/A

If well telescopes please sketch and show depths.

GROUND LEVEL

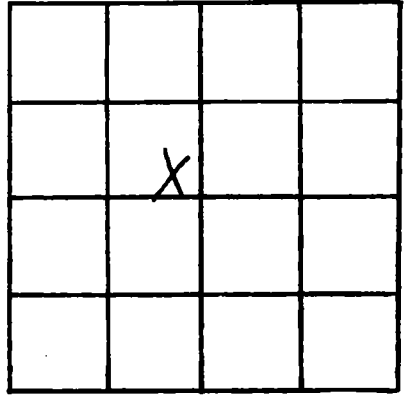

SECTION 8

Please indicate well location X.

ADDITIONAL INFORMATION

If more than one screen,
show locations of each on sketch.