

MISSISSIPPI DEPARTMENT OF NATURAL RESOURCES

Bureau of Land and Water Resources

Southport Mall

P.O. Box 10631

Jackson, Mississippi 39209

WATER WELL DRILLERS LOG

CODED

Hancock
K 448

July 14, 1986 Ward Well Dr. Hancock
 date well completed firm name county well located
Calvary Independent

LANDOWNER: Baptist Church
P.O. Box 335
Waveland, Mr.
 (mailing address)

WELL LOCATION:
 sec. 22 T. 8 N R. 14 E
1 miles N of Waveland
 (distance) (direction) (nearest town)

WELL PURPOSE: Church
 (home, irrigation, municipal, industrial)

WELL COMPLETION DATA:

(1) diameter (inches) 2"

(2) total depth (feet) 336

(3) static water level (feet) 8 below top of ground.

(4) casing PVC, 326
 (material) (depth)

(size) If telescope see back.

(5) screen 10', -
 (length) (depth to top)

2", PVC
 (size) (material)

(6) pump owner, -
 (HP) (yield gpm)

(type power)

(7) electric log NO
 (yes or no)

(organization running log) N/A

(8) how well bottom plugged BWC

description of formations encountered	from	to
<u>fill</u>	<u>0</u>	<u>3</u>
<u>clay</u>	<u>3</u>	<u>21</u>
<u>sd</u>	<u>21</u>	<u>48</u>
<u>clay</u>	<u>48</u>	<u>105</u>
<u>sd</u>	<u>105</u>	<u>110</u>
<u>6 clay - silt</u>		
<u>W/d s. streak</u>	<u>110</u>	<u>275</u>
<u>med. cone sd</u>	<u>275</u>	<u>336</u>


RECEIVED
 AUG 21 1986
 CODED

Department of Natural Resources
 Bureau of Land & Water Resources

DRILLERS REMARKS: N/A

If well telescopes please sketch and show depths.

GROUND LEVEL

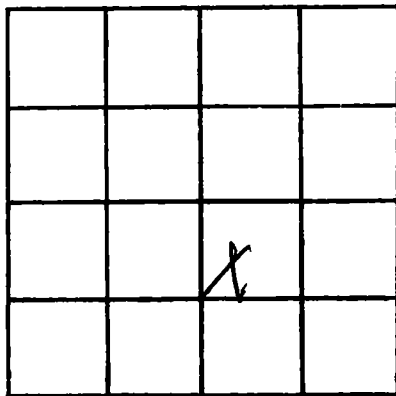

SECTION 27

Please indicate well location X.

ADDITIONAL INFORMATION

If more than one screen,
show locations of each on sketch.