

MISSISSIPPI DEPARTMENT OF NATURAL RESOURCES
Braden Pump & Well Service, Inc. Bureau of Land and Water Resources

P.O. Box 10631
 Jackson, Mississippi 39209
WATER WELL DRILLERS LOG

COUNTY WELL LOCATED IN: Hancock **CODED**

WELL NUMBER: K 458 **CODED**

PERMIT NUMBER: 17170 Country Cove

DATE WELL COMPLETED: 30-19-12
89-20-26

NAME OF DRILLING FIRM: Saucier, MS 39574
M & B Drilling Co.

NAME & MAILING ADDRESS OF LANDOWNER:
 Chris Crighton
 502 B Sunset Drive
 Bay St. Louis, Miss 39520

WELL LOCATION: SEC 42 29 8 13W 14S 14W

DISTANCE: 1 Miles **DIRECTION:** N **NEAREST TOWN:** of Hazy 90

OTHER LANDMARK: In the City

WELL PURPOSE: Home, Irrigation, Municipal, Industrial, Fish Pond, etc.
Home

PUMP DATA

PUMP TYPE (Circle One): S.W. Submersible, Turbine, Jet, Flowing Well, Other (Describe) _____

POWER TYPE (Circle One): Electric, Tractor, Diesel, Gasoline, Butane, Other (Describe) _____

Pump Capacity (GPM)	No. of Stages	Setting Depth
		FT.

PUMP TEST

Well yielded _____ GPM with a drawdown of _____ ft. after _____ hours of pumping

WELL DATA

Well Depth 540	Casing Diameter (In.) 2"	Casing Length (Ft.) 520
Type of Casing PVC	Hole Depth 540	Depth to Static Water Level + 10 FT

TYPE OF COMPLETION: (Circle One or More):
 Gravel Packed, Underreamed, Telescoped, Natural Development, Open Hole, Other (Describe) _____

Top of Lap Pipe or Reduction in Casing

FEET	IF TELESCOPED OR MORE THAN ONE SCREEN: USE BACK PAGE
------	--

LOG DATA

TYPE OF LOG RUN (Circle One): No Log Run, Electric, Gamma Ray, Density, Sonic, Neutron, Other (Describe) _____

Name of Organization Running Log _____

SCREEN DATA

Diameter - Inches 2"	Length - Feet 10	Slot Size - Inches .008
Screen Type PVC WOP	Depth to Bottom - Feet 530-10 FT Tail Pipe	

GEOLOGIC DATA (Office Use Only)

Surface Elev.	Geologic Unit	Unit Thickness	Depth to Top
Subs. SWL	Date	Analysis	Aquifer Test

Driller's Remarks


RECEIVED

DESCRIPTION OF FORMATIONS ENCOUNTERED	FROM	TO	FORMATIONS (Continued)	DEPTH	TO
Surface	0	6	AUG 14 1987 Department of Natural Resources Bureau of Land & Water Resources		
Black Clay	6	10			
White Sand	10	44			
Grey Clay	44	120			
Blue Sand	120	150			
Blue Clay	150	360			
Sand & Clay Brkls	360	440			
Blue Clay	440	470			
Grey Sand	470	538			
Blue Clay	538	540 +			

IF MORE SPACE IS NEEDED, USE BACK

If well telescopes please sketch and show depths.

GROUND LEVEL

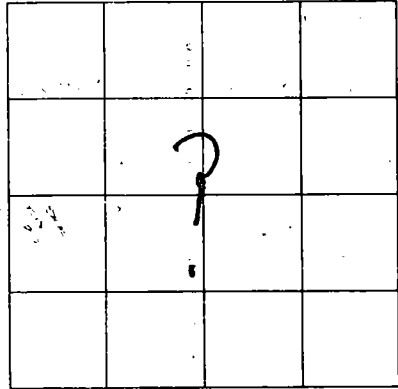

SECTION 42

Please indicate well location X.

ADDITIONAL INFORMATION

Lined area for additional information.

If more than one screen, show location of each on sketch.