

15909

MISSISSIPPI DEPARTMENT OF ENVIRONMENTAL QUALITY

Office of Land and Water Resources

P. O. Box 10631
Jackson, MS 39289-0631
WATER WELL DRILLERS LOG

COUNTY WELL LOCATED	
Hancock	
WELL NUMBER	CODED
R-291	
DATE WELL COMPLETED	
4/10/03	

NEW-15909

PERMIT NUMBER
0404
NAME OF DRILLING FIRM
Cynar Well Co.
Address
Myrtle, Ms. 39503

NAME & MAILING ADDRESS OF LANDOWNER			
TEST I 1770 PO Box			
Ocean Springs MS 39566-1700			
Latitude:			
Longitude:			
WELL LOCATION	SEC	TOWNSHIP	RANGE
	17	9	14 E
DISTANCE	DIRECTION	NEAREST TOWN	
Miles	of		
OTHER LANDMARK			
Clermont Harbor			
WELL PURPOSE: Home, Irrigation, <u>Municipal</u> , Industrial, Fish Pond, etc.			

PUMP DATA
PUMP TYPE (Circle One):
Submersible, <u>Turbine</u> , Jet, Flowing Well,
Other (Describe)
POWER TYPE (Circle One):
<u>Electric</u> , Tractor, Diesel, Gasoline, Butane,
Other (Describe) H/P 15

DESCRIPTION OF FORMATIONS ENCOUNTERED	FROM	TO
TOP soil sandy clay	0	100
sand	100	120
blue clay	120	280
sand	280	360
blue clay	360	730
coarse & medium sand	730	840

WELL DATA

Well Depth	Casing Diameter (in.)	Casing Length (ft.)
840	12"	730
Type of Casing	Hole Depth	Depth to Static Water Level
steel	842	+ 3'
TYPE OF COMPLETION: (Circle One or More):		
General Packed, <u>Underreamed,</u> <u>Telescoped</u>	Natural Development, Open Hole, Other	
(Describe)		
WELL GROUTED TO A DEPTH OF 730 FEET		
Type Grout (circle one): Cement, Bentonite, or Mix		

RECEIVED

MAY 01 2003

BY: OLWR

SCREEN DATA

Diameter - Inches	Length - Feet	Slot Size - Inches
8"	60'	.010
Screen Type	Depth to Bottom - Feet	
5 wrap	840	

Top of Lap Pipe or Reduction in Casing
670 FEET
IF TELESCOPED OR MORE THAN ONE SCREEN: USE BACK PAGE

I certify that the well was drilled, constructed and completed in accordance with all applicable Requirements of the Mississippi Department of Environmental Quality and/or the Mississippi Department of Health regulations and state laws.


Josh Ladner 0-640
Signature of Licensed Driller and License No.

4/10/03
Date

Additional Information Required On Back

If well telescopes please sketch and show depths.

GROUND LEVEL

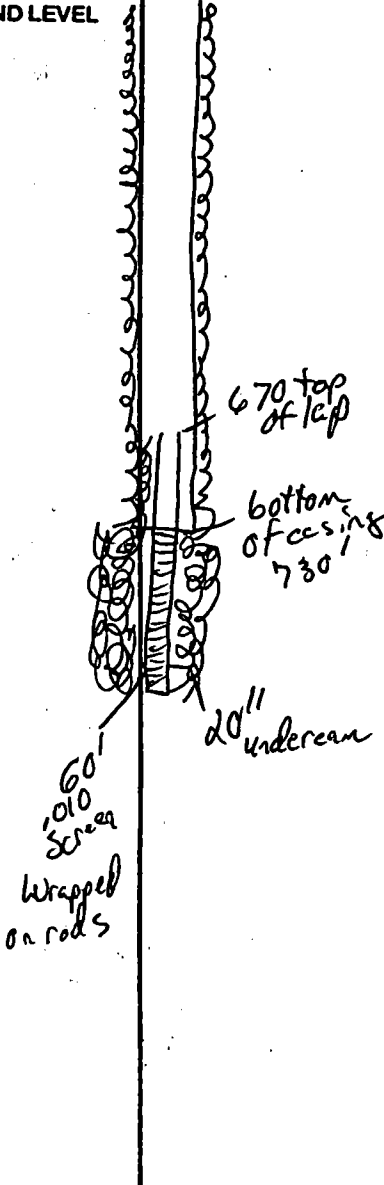

SECTION _____

Please indicate well location X.

Pump Capacity (GPM)	No. of Stages	Setting Depth
350	4	50 FT.

PUMP TEST

Well yielded _____ GPM with a drawdown of _____ ft. after _____ hours of pumping

LOG DATA

TYPE OF LOG-RUN (Circle One): No Log Run, Electric, Gamma Ray, Density, Sonic, Neutron, Other (Describe) _____

Name of Organization Running Log _____

GEOLOGIC DATA (Office Use Only)

Surface Elev.	Geologic Unit	Unit Thickness	Depth to Top
Subs. SWL	Date	Analysis	Aquifer Test

Driller's Remarks

If more than one screen, show location of each on sketch.