
- •	State Well Report	
County: Dam COCK	Part 1 – Driller's Log	For Office Use Only
Permit #:	Mississippi Department of Environmental Quality Office of Land and Water Resources	Aquifer:
Driller, Alcaioe Well	P.O. Box 10631	Well #: <u><u><u> </u></u></u>
QIOT.	Jackson, MS 39289-0631	L. S. Elevation:
Date drilling completed:	(601)961-5210 (601)354-6938 (fax)	E-log #:
	rt be prepared by the license holder responsible for t	
Information on Well C	<i>within 30 days of completion of drilling of the well</i> Dwner Well or Bo	rehole Location
(Landowner if borehole is not f		" Longitude:'
Owner Name Mabutat is	r, Cummity	-
Mailing Address: 4057 6	PLICUI (Method of Lat/Long (circle or	e): Conventional Survey,
	USGS quad, Hand-held	GPS, Survey-grade GPS
12 CL Pa	¼ ¼ Sec	<u></u>
<u>15411 DT D</u> City (1513	tte Zip Code Distance Direction	Nearest Town
4/10	9/ADD Miles	Nearest Town of Lakeshore
Telephone No. () 10 [-		
-) 100	Well / Borehole Data	1
Date drilling started: 4 -1-07 Date dr	illing completed: 81-07 Hole depth: 130	Hole diameter: <u>H</u>
Location of the source of any surface wat	er used for drilling: Nom COLATY	abter & Sou
Method of dosing and volume of Chlorin	e used in drilling and development:	
Logs run (circle all applicable) No log ru	D Electric Gamma Ray Density Sonic Neutron	Other:
Name of organization running log(s):		
Purpose of borchole (check one): Water W	ell Geotechnical/Geological Investigation Ground	Source Heat Pump
	Survey Other ( <i>describe</i> )	
If drilling is not related	d to water_well construction, skip the remainder of this bl	ock
Purpose of Well (check one): Home	Industrial Public Supply Irrigation Fish Culture	Other:
If a flowing well, method of flow regulation	on: Valve Other (describe)	
	bove or below (circle one) land surface Date measured:	8-1-07
Ľ		
Method of Measurement (circle one)		nent Bentonite Mix
Well depth: 120 Well grouted to a de	· · · ·	
Well depth: 120 Well grouted to a de	· · · ·	PVC
Well depth: 120 Well grouted to a de Casing length: 10 feet Casi	ng diameter: $2^{(1)}$ inches Type of casing:	PVC PVC
Well depth: 120 Well grouted to a de Casing length: 10 feet Casi Screen length: 20 feet Screen	ng diameter: $2^{l'}$ inches Type of casing: een diameter: $2^{l'}$ inches Type of screen:	PVC PVC
Well depth: 120 Well grouted to a de Casing length: 10 feet Casi Screen length: 20 feet Scree Screen slot size: 20 6 inches	ng diameter: <u>2</u> <sup>11</sup> inches Type of casing: een diameter: <u>3</u> <sup>12</sup> inches Type of screen: Setting depth: Fromfeet to	PVC PVC 120_feet
Well depth: 120 Well grouted to a de Casing length: 10 feet Casi Screen length: 20 feet Scree Screen slot size: 20 6 inches	ing diameter: <u>2</u> <sup>(1)</sup> inches Type of casing: een diameter: <u>3</u> <sup>(1)</sup> inches Type of screen: Setting depth: From <u>10</u> feet to Gravel packed Underreamed Telescoped Open	PVC PVC 120_feet hole Natural Developm
Well depth: 120 Well grouted to a de Casing length: 10 feet Casi Screen length: 10 feet Scree Screen slot size:	ing diameter: inches Type of casing: een diameter: inches Type of screen: Setting depth: From feet to Gravel packed Underreamed Telescoped Open Other (describe):	PVC PVC 120_feet hole Natural Developm
Well depth: 120 Well grouted to a de Casing length: 10 feet Casi Screen length: 10 feet Scree Screen slot size:	ing diameter: <u>2</u> <sup>(1)</sup> inches Type of casing: een diameter: <u>3</u> <sup>(1)</sup> inches Type of screen: Setting depth: From <u>10</u> feet to Gravel packed Underreamed Telescoped Open	PVC PVC 120_feet hole Natural Developm

.

JAN 2 2 2008 **BY: OLWR** 



## The sketch below only required for water wells

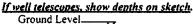


<u>s on sketch</u> .			
	Description of Formations Encountered	From (depth)	To (depth)
· · · · · · · · · · · · · · · · · · ·		Ground Level	
	Mup	0	20
	SAND	<u>ao</u>	40
	B. CIAY	110	90
	SAND'	90	120
		_	
			ļ
			<u> </u>
			<u> </u>
			1

Description of formations encountered must be provided for all wells and boreholes, unless specifically exempted by regulations

If more than one screen, show location of each on sketch

1

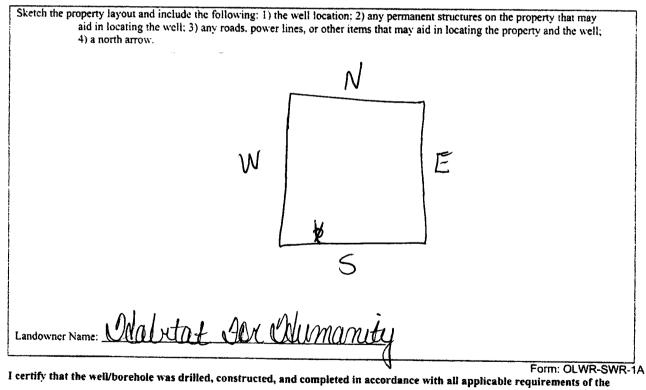

Mississippi Department of Environmental Quality and the Mississippi Department of Health regulations, if applicable, and state

Print Name of Responsible Licensee and License No.

Date

Foht	
Signatu	re of Licensee

**BY: OLWR** 

JAN 2 2 2008

	STATE WELL REPORT						
	County: <u>StamCoc K</u> Permit #: Driller: TLCOUSE [Well	Pump Installer' Mississippi Departmen Office of Land	Part 2 s Completion Report at of Environmental Quality and Water Resources	For Office Use Only: Aquifer:			
	Date completed: $10 - 8 - 07$ Copy information from block on Part 1	Jackson, N (601)	Box 10631 AS 39289-0631 1961-5210 14-6938 (fax)	Well #: <u>K - 559</u> Elevation:			
	This part of the report must be completed by a licensed water well contractor or a licensed pump installer. A copy of Part 1 of the report must be attached and both parts filed with the Department at the above address within 30 days of well completion.						
	Well Owner Informat	1 Aumaril	Well Location Latitude:Longitude:				
	Mailing Address: 0057 6.	Rony	Method of Lat/Long (check or	ne): Conventional Survey, GPS, Survey-grade GPS			
	City Size	LLO, MS Zip Code	¼¼ Sec				
	Telephone No. () 467-0	9699	Distance Direction Nearest Town <u></u>				
	Pump Type Circle one		Power Type Circle one				
	Air Lift Jet	Submersible	Diesel Engine Gasolin	e Engine Natural Gas			
	Bucket Piston Centrifugal Rotary	Turbine Flowing Well	Electric Motor Hand Windmill Other (	Tractor PTO			
-	Other (specify):		Horse Power Rating of Motor:	1			
	Date Pump Installed: 10-8-07 Rated Pump Capacity: 10	Gallons Per Minute	Setting Depth:	)feet			
	Pump Test Data		Method of Measuring Water Level Circle one				
	Date Well Tested:Feet I Static Water Level (A):Feet I Pumping Water Level (B):Feet E		Air Line Electric Meas Other (specify):	suring Linc Steel Tape			
	Drawdown [(B) – (A)]:Feet 1		For flowing well, measured shi	ut in head:feet			
	Test Pumping Rate: Duration of Pump Test (minimum 4 hours): .		Well yielded				
		nours	feet after	hours of pumping			
	I HEREBY CERTIFY that the above stateme Robert Necaise Print Name of Pump Installer and License No	0-400	Signature of Pump Ins				
				JAN 2 2 2008			
				BY: OLWR			

•