County: Permit #: Driller: Date drilling completed: Q-13-07	State Well Report Part 1 – Driller's Log Mississippi Department of Environmental Quality Office of Land and Water Resources P.O. Box 10631 Jackson, MS 39289-0631 (601)961-5210 (601)354-6938 (fax)		For Office Use Only: Aquifer:			
State Law requires that this report be prepared by the license holder responsible for the work and filed with the Department at the above address within 30 days of completion of drilling of the well or borehole.						
Information on Well Owner			Well or Borehole Location			
(Landowner if borehole is not for a water well) Owner Name Daly Tat Du Oluminuty Mailing Address: 4184 W. Granda Bay St Aus M S		Latitude:'' Longitude:' " Method of Lat/Long (circle one): Conventional Survey, USGS quad, Hand-held GPS, Survey-grade GPS '4'4 Sec Twn_ 9 Srng_14W				
City J Sta Telephone No. () 407-	te Zip Eode 9699	Distance Direction Miles	of Labeshore			
$Q_{-13,07} \qquad \qquad$						

5

,

,

Day of Alloy 1/5 City State Zip Code Distance Distance Direction None No. () 407-9699					
Well / Borehole Data Date drilling started: 9-13.07 Date drilling completed: 9-13.07 Hole depth: 130 Hole diameter: 4					
Location of the source of any surface water used for drilling: <u>NOMCOCK</u> COLLATY UNTURE SUPER Method of dosing and volume of Chlorine used in drilling and development:					
Logs run (circle all applicable): No log run Electric Gamma Ray Density Sonic Neutron Other:					
Purpose of borehole (check one): Water Well Geotechnical/Geological Investigation Ground Source Heat Pump					
Seismic SurveyOther (<i>describe</i>) If drilling is not related to water well construction, skip the remainder of this block					
Purpose of Well (check one): HomeIndustrial Public Supply Irrigation Fish Culture Other:					
If a flowing well, method of flow regulation: Valve Other (describe) Static Water Level:feet above or below (c)rcle one) land surface Date measured: 9-13-07					
Method of Measurement (circle one) steel tape electric tape air line other: Well depth: 130 Well grouted to a depth of 10 feet Type of grout (circle one): Neat Cement Bentonite Casing length: 120 feet Casing diameter: inches Type of casing: VC Screen length: 10 feet Screen diameter: inches Type of screen: VC					
Screen slot size: <u>006</u> inches Setting depth: From <u>190</u> feet to <u>130</u> feet					
Type of completion (circle all applicable) Gravel packed Underreamed Telescoped Open hole Natural Development					
Other (describe):					
Top of lap pipe or reduction in casing:feet. If telescoped or more than one screen, describe on next page					
Forma OLWR-SWR-14					

JAN 2 2 2008


BY: OLWR

The sketch below only required for water wells

If well telescopes, show denths on sketch. Ground Level Description of formations encountered must be brovided for all wells and boreholes, unless specifically exempted by regulations

Description of Formations Encountered	From (depth)	To (depth)
	Ground Level	
Hud.	0	20
SAND.	70	62
BCLHY	1.0	TGO
STAND	160	130
	L L	
		1

If more than one screen, show location of each on sketch

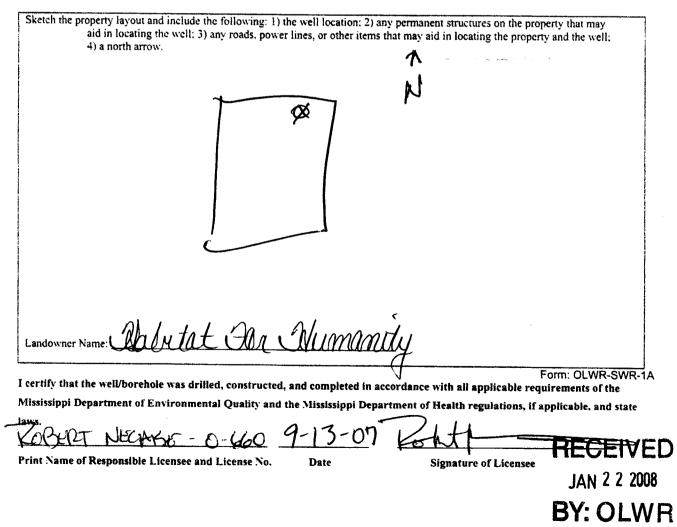

STATE WELL REPORT						
County: <u>HPNCOCIL</u> Permit #: Driller: <u>NECHiff</u> WELL Date completed: <u>9-25-07</u> <u>Copy information from block on Part 1</u>	Part 2 Pump Installer's Completion Report Mississippi Department of Environmental Quality Office of Land and Water Resources P.O. Box 10631 Jackson, MS 39289-0631 (601)961-5210 (601)354-6938 (fax)		For Office Use Only: Aquifer:			
This part of the report must be completed by a licensed water well contractor or a licensed pump installer. A copy of Part 1 of the report must be attached and both parts filed with the Department at the above address within 30 days of well completion. Well Owner Information Well Location						
		Latitude: Longitude:				
Mailing Address: (0)844).	Sremada	Method of Lat/Long (check on	e): Conventional Survey,			
City State Zip Code Telephone No. () 467-9699		USGS quad, Hand-held GPS, Survey-grade GPS ¼ ¼ Sec T R L_ Distance Direction Nearest Town Miles of AMES NOTE				
Pump Type Circle one		Power Type Circle one				
	Submersible		e Engine Natural Gas			
Bucket Piston	Turbine	Electric Motor Hand	Tractor PTO			
Centrifugal Rotary	Flowing Well	Windmill Other (specify):			
Other (specify):	<u> </u>	Horse Power Rating of Motor:				
Date Pump Installed: 9-25-05 Rated Pump Capacity: 10	Gallons Per Minute	Setting Depth:feet Number of Stages:				
Pump Test Data		Method of Mcasuring Water Level Circle one				
Date Well Tested: Static Water Level (A):Feet E Pumping Water Level (B):Feet B		Air Line Electric Meas	suring Linc Steel Tape			
Drawdown [(B) - (A)]:Feet Below Land Surface		For flowing well, measured sh	ut in head:feet			
Test Pumping Rate:C	Gallons Per Minute	Well yielded	_GPM with a drawdown of			
Duration of Pump Test (minimum 4 hours):	hours	feet after	hours of pumping			
IHEREBY CERTIFY that the above stateme <u>KUBENT NEUACE</u> Print Name of Pump Installer and License No	0-660	Emy knowledge.	staller RECEIVED JAN 2 2 2008			

^н ун- т э

BY: OLWR