
Part 2 never received	3/B State Well Deport	
county: Mancock	State Well Report Part 1 – Driller's Log	For Office Use Only:
	Mississippi Department of Environmental Quality	Aquifer:
Permit #:	Office of Land and Water Resources	Well#: K 583
Driller: Acauno Well	P.O. Box 10631	weil #:
	Jackson, MS 39289-0631	L. S. Elevation:
Date drilling completed:	(601)961-5210	
	(601)354-6938 (fax)	E-log #:

State Law requires that this report be prepared by the license holder responsible for the work and filed with the Department at the above address within 30 days of completion of drilling of the well or borehole.

Information on Well Owner	Well or Borehole Location			
(Landowner if borehole is not for a water well) \bigcirc	Latitude: 30 .17 .35 " Longitude: 83. 25.40 "			
Owner Name_STC	• • • • • • • • • • • • • • • • •			
Mailing Address: 4003 E. Holoto	Method of Lat/Long (circle one): Conventional Survey,			
	USGS quad, Hand-held GPS, Survey-grade GPS			
Bay St Louis MS	SE 1/ NE 1/ Sec (p Twn 95 Rng 4 W			
City State Zip Code	Distance Direction Nearest Town Miles of OKES HOVE			
Telephone No. (UD) 749-3595				
Well / Bore	hole Data			
Date drilling started: $9 - 19 - 07$ Date drilling completed: $9 - 19 \cdot 07$ Hole depth: 130 Hole diameter: 4				
Location of the source of any surface water used for drilling: <u>Nancock</u> Courty Water & Sewer Method of dosing and volume of Chlorine used in drilling and development:				
Logs run (circle all applicable): No log run Electric Gamma Ray	Density Sonia Mautron Other			
Name of organization running log(s):				
Purpose of borehole (check one): Water Well Geotechnical/Geological Investigation Ground Source Heat Pump				
Seismic Survey Other (<i>describe</i>)				
Purpose of Well (check one): HomeIndustrial Public Supply Irrigation Fish Culture Other:				
If a flowing well, method of flow regulation: Valve Other (describe)				
Static Water Level:				
Method of Measurement (circle one) steel tape electric tape air line other:				
Well depth: 130 Well grouted to a depth of 40 feet Type	of grout (circle one): Neat Cement Bentonite Mix			
Casing length: 120 feet Casing diameter:	_inches Type of casing: PVC			
Screen length: <u>10</u> feet Screen diameter: <u>2</u>	_inches Type of screen: PVC			
Screen slot size: <u>COLO</u> inches Setting depth: From <u>120</u> feet to <u>130</u> feet				
Type of completion (circle all applicable); Gravel packed Underreamed Telescoped Open hole Natural Development				
Other (describe):				
Top of lap pipe or reduction in casing:feet. If tel	escoped or more than one screen, describe on next page			
	FRECEWED			
CONTONIE &	ELSE JAN 2 2 2008			
JOILE OLOS	DUMP			
INGTALLEN	BY: OLWR			
SOME ONE E INSTALLED FAXED W	ien perpoint			




The sketch below only required for water wells

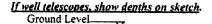

Description of formations encountered must be provided for all wells and boreholes, unless specifically exempted by regulations

	Description of Formations Encountered	From (depth)	To (depth)
İ		Ground Level	
	MUD		20
	SANA	70	70
	KCLAY	70	100
	SAND	100	430
1			
			1

If more than one screen, show location of each on sketch

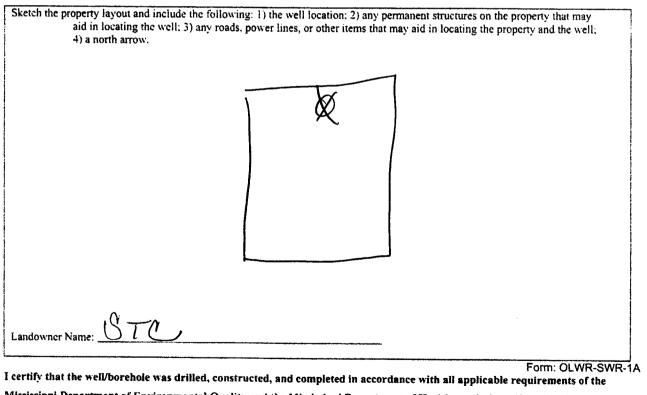

Mississippi Department of Environmental Quality and the Mississippi Department of Health regulations, if applicable, and state

- 0-0

Print Name of Responsible Licensee and License No.

Date

Signature of Licensee RECEIVED JAN 2 2 2008

BY: OLWR