

County: HANCOCK  
 Permit #: \_\_\_\_\_  
 Driller: ACUSTIC WELL  
 Date drilling completed: 11-15-07

### State Well Report

#### Part 1 - Driller's Log

Mississippi Department of Environmental Quality  
 Office of Land and Water Resources  
 P.O. Box 10631  
 Jackson, MS 39289-0631  
 (601)961-5210  
 (601)354-6938 (fax)

For Office Use Only:  
 Aquifer: \_\_\_\_\_  
 Well #: K-622  
 L. S. Elevation: \_\_\_\_\_  
 E-log #: \_\_\_\_\_

*State Law requires that this report be prepared by the license holder responsible for the work and filed with the Department at the above address within 30 days of completion of drilling of the well or borehole.*

Information on Well Owner <i>(Landowner if borehole is not for a water well)</i>	Well or Borehole Location
Owner Name: <u>Creek Stream Development</u>	Latitude: _____ Longitude: _____
Mailing Address: <u>4108 E. Floagunna</u>	Method of Lat Long (circle one): Conventional Survey, USGS quad. Hand-held GPS, Survey-grade GPS
<u>Bayest Louis, MS</u> City State Zip Code	1/4 Sec <u>6</u> Twn <u>9S</u> Rng <u>14W</u>
Telephone No. <u>(337) 549-7718</u>	Distance <u>2</u> Miles Direction <u>N</u> of Nearest Town <u>Lakeshore</u>

**Well / Borehole Data**

Date drilling started: 11-15-07 Date drilling completed: 11-15-07 Hole depth: 160 Hole diameter: 4"

Location of the source of any surface water used for drilling: HANCOCK COUNTY WATER-SHED

Method of dosing and volume of Chlorine used in drilling and development: \_\_\_\_\_

Logs run (circle all applicable): No log run Electric Gamma Ray Density Sonic Neutron Other: \_\_\_\_\_

Name of organization running log(s): \_\_\_\_\_

Purpose of borehole (check one): Water Well  Geotechnical Geological Investigation \_\_\_\_\_ Ground Source Heat Pump \_\_\_\_\_ Seismic Survey \_\_\_\_\_ Other (describe) \_\_\_\_\_

*If drilling is not related to water well construction, skip the remainder of this block*

Purpose of Well (check one): Home  Industrial \_\_\_\_\_ Public Supply \_\_\_\_\_ Irrigation \_\_\_\_\_ Fish Culture \_\_\_\_\_ Other: \_\_\_\_\_

If a flowing well, method of flow regulation: Valve \_\_\_\_\_ Other (describe) \_\_\_\_\_

Static Water Level: 12 feet above or below (circle one) land surface Date measured: 11-15-07

Method of Measurement (circle one) steel tape electric tape air line other: \_\_\_\_\_

Well depth: 160 Well grouted to a depth of 10 feet Type of grout (circle one): Neat Cement Bentonite Mix

Casing length: 150 feet Casing diameter: 2" inches Type of casing: PVC

Screen length: 10 feet Screen diameter: 2" inches Type of screen: PVC

Screen slot size: 600 inches Setting depth: From 150 feet to 160 feet

Type of completion (circle all applicable): Gravel packed Underreamed Telescoped Open hole Natural Development Other (describe): \_\_\_\_\_


Top of lap pipe or reduction in casing: \_\_\_\_\_ feet. *If telescoped or more than one screen, describe on next page*


For OLWR SWR-1A  
**RECEIVED**  
 JAN 22 2008  
 BY: OLWR

K622

The sketch below only required for water wells.

If well telescopes, show depths on sketch.

Ground Level 

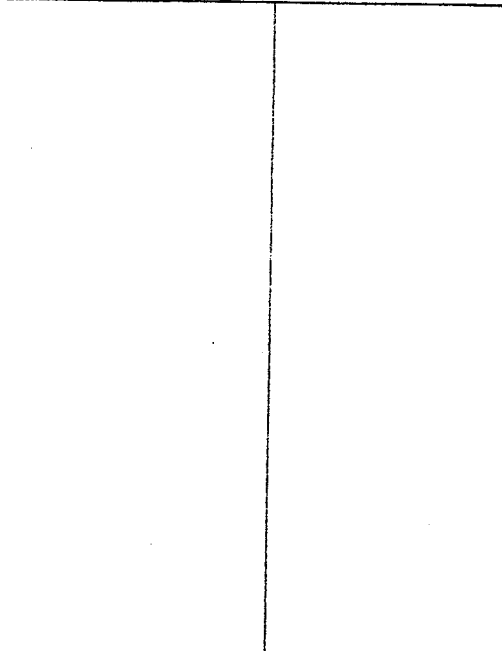


Description of formations encountered must be provided for all wells and boreholes, unless specifically exempted by regulations

Description of Formations Encountered	From (depth)	To (depth)
	Ground Level	

If more than one screen, show location of each on sketch

Sketch the property layout and include the following: 1) the well location; 2) any permanent structures on the property that may aid in locating the well; 3) any roads, power lines, or other items that may aid in locating the property and the well; 4) a north arrow.

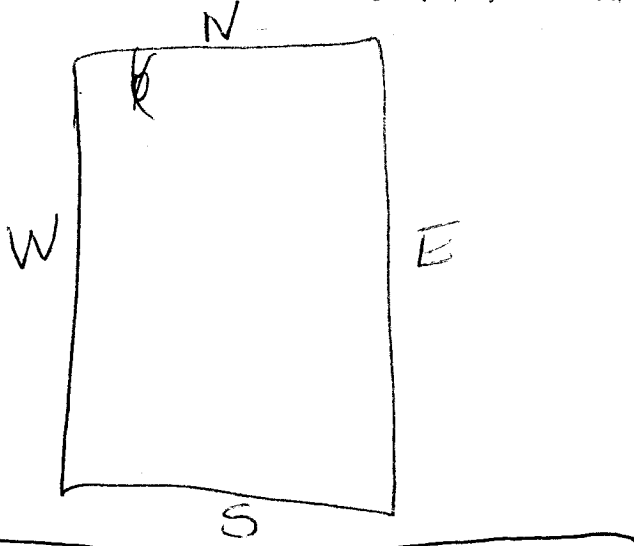

Landowner Name: Cree Stream Development

I certify that the well/borehole was drilled, constructed, and completed in accordance with all applicable requirements of the Mississippi Department of Environmental Quality and the Mississippi Department of Health regulations, if applicable, and state laws.

Form: OLWR-SWR-1A

ROBERT NECASE - 0-660 11-15-07

Robert

Print Name of Responsible Licensee and License No.

Date

Signature of Licensee

RECEIVED

JAN 22 2008

BY: OLWR

# STATE WELL REPORT

## Part 2

**Pump Installer's Completion Report**  
 Mississippi Department of Environmental Quality  
 Office of Land and Water Resources  
 P.O. Box 10631  
 Jackson, MS 39289-0631  
 (601)961-5210  
 (601)354-6938 (fax)

County: HANCOCK  
 Permit #: \_\_\_\_\_  
 Driller: NECHISE WELL  
 Date completed: 12-20-07  
*Copy information from block on Part 1*

**For Office Use Only:**

Aquifer: \_\_\_\_\_  
 Well #: 1K622  
 Elevation: \_\_\_\_\_

*This part of the report must be completed by a licensed water well contractor or a licensed pump installer. A copy of Part 1 of the report must be attached and both parts filed with the Department at the above address within 30 days of well completion.*

Well Owner Information	Well Location
Owner Name: <u>Creek Stream Development</u>	Latitude: _____ Longitude: _____
Mailing Address: <u>6108 E. Esquiviera</u>	Method of Lat/Long (check one): Conventional Survey _____ USGS quad _____, Hand-held GPS _____, Survey-grade GPS _____ _____ 1/4 _____ 1/4 Sec <u>6</u> T <u>9</u> R <u>14</u>
<u>Bay St. Louis, MS</u> City State Zip Code	Distance Direction Nearest Town <u>2</u> Miles <u>W</u> of <u>Lakeshore</u>
Telephone No. <u>(393) 549-7718</u>	

Pump Type Circle one	Power Type Circle one
Air Lift            Jet                      Submersible	Diesel Engine      Gasoline Engine      Natural Gas
Bucket             Piston                    Turbine	<u>Electric Motor</u> Hand                      Tractor PTO
<u>Centrifugal</u> Rotary                    Flowing Well	Windmill            Other (specify): _____
Other (specify): _____	Horse Power Rating of Motor: <u>1</u>
Date Pump Installed: <u>12-20-07</u>	Setting Depth: <u>40'</u> feet
Rated Pump Capacity: <u>10</u> Gallons Per Minute	Number of Stages: <u>1</u>

Pump Test Data	Method of Measuring Water Level Circle one
Date Well Tested: _____	Air Line            Electric Measuring Line <u>Steel Tape</u>
Static Water Level (A): _____ Feet Below Land Surface	Other (specify): _____
Pumping Water Level (B): _____ Feet Below Land Surface	For flowing well, measured shut in head: _____ feet
Drawdown [(B) - (A)]: _____ Feet Below Land Surface	Well yielded _____ GPM with a drawdown of _____ feet after _____ hours of pumping
Test Pumping Rate: _____ Gallons Per Minute	
Duration of Pump Test (minimum 4 hours): _____ hours	

I HEREBY CERTIFY that the above statements are true to the best of my knowledge.

ROBERT NECHISE 0-660                      [Signature]  
 Print Name of Pump Installer and License No. (if applicable)                      Signature of Pump Installer

**RECEIVED**  
 Form: OLWR-SWR-1B  
 JAN 22 2008  
 BY: OLWR