
State W	ell Report	
County: HANCOCK Part 1 - I	Driller's Log	For Office Use Only:
Mississippi Departmen	t of Environmental Quality	Aquifer:
	nd Water Resources	Well #: K-697
Driller NUCKUR DECC	Box 10631	
10 11 61 1	IS 39289-0631 961-5210	L. S. Elevation:
Date drilling completed:(001)	4-6938 (fax)	E-log #:
State Law requires that this report be prepared by the lic		
Department at the above address within 30 days of comp		or borehole. rehole Location
Information on Well Owner (Landgwner if borehqle is not for a water well)	wen or bo	renoie Location
	Latitude:°'	" Longitude:'"
Owner Name Garcibayle Uno		a). Conventional Surroy
Mailing Address: Lot 41 & Madroon	Method of Lat/Long (circle on	ie): Conventional Survey,
	USGS quad, Hand-held	GPS, Survey-grade GPS
	¼ ¼ Sec()	The General Hard
MUNT NOUD 4113	74 74 Sec	
City State Zip Code	Distance Direction	of LAKESHORE
Telephone No 228, 255-2276	Miles	of LAKESFOR
Telephone No. 2000 000 0000 00000000000000000000000		
Well / Bore	hole Data	
Date drilling started: 2-1307 Date drilling completed: 2-13	07.1.1. 120	Hala diamatan
		-
Location of the source of any surface water used for drilling:	ANCOCK COUNT	4 WATER - Sewer
Method of dosing and volume of Chlorine used in drilling and deve	lopment:	
Logs run (circle all applicable) No log run Electric Gamma Ray	Density Sonic Neutron	Other:
Name of organization running log(s):	Denský Seine Roudon	
Purpose of borchole (check one): Water Well 🗹 Geotechnical/Geo	ogical Investigation Ground	Source Heat Pump
Seismic Survey Other (describe	?)	
If drilling is not related to water well construction	on, skip the remainder of this bl	ock
Purpose of Well (check one): Home / Industrial Public Suppl	v Irrigation Fish Culture	Other:
-		
If a flowing well, method of flow regulation: Valve O	Other (describe)	
Static Water Level: 12 feet above of below (circle one)	land surface Date measured:	12.13-07
Method of Measurement (circle one) steel tape electric tape	air line other:	
Well depth: 120 Well grouted to a depth of 10 feet Typ	e of grout (circle one). Neat Cen	ent Bentonite (Mix)
Casing length: <u>110</u> feet Casing diameter: <u>2</u>	inches Type of casing:	PVC
Screen length: <u>10</u> feet Screen diameter: <u>2</u> "	inches Type of screen:	PUC
	ino la	
Screen slot size: <u>OOC</u> inches Setting depth: From	feet to	feet
Type of completion (circle all applicable): Gravel packed Unde	meamed Telesconed Open	hole Natural Development
Type of completion (circle an applicable).	incained releasedped open	The Automatic Development
Other (describe):	· · · · · · · · · · · · · · · · · · ·	18.01/2
Top of lap pipe or reduction in casing:feet. If to	lesconed or more than one com	oon describe on next nooe
Top of tap pipe of reduction in casingifeet. If it	acsevpen of more inten one scre	en, acsente en next page
		Form: OLWR-SWR-14
		RECEIVE
		JAN 2 2 200
		BY: OLW

۰.

.




## The sketch below only required for water wells

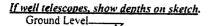

Description of formations encountered must be provided for all wells and boreholes, unless specifically exempted by regulations

Description of Formations Encountered	From (depth)	To (depth)
A	Ground Level	
MUD	0	20
SAND	70	60
<u>BCCAY</u>	60	100
SIAN D	100	120
		1
		1
	1	
	1	1
	1	1
		1
	1	1
	1	1
	1	1

If more than one screen, show location of each on sketch

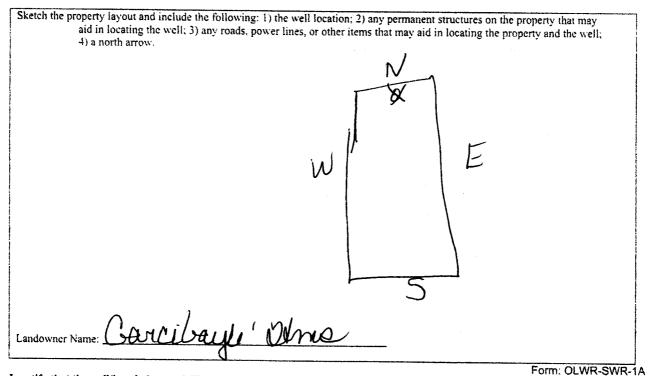

I certify that the well/borehole was drilled, constructed, and completed in accordance with all applicable requirements of the Mississippi Department of Environmental Quality and the Mississippi Department of Health regulations, if applicable, and state

Print Name of Responsible Licensee and License No.

Date

REGEIVED Signature of Licensee JAN 2 2 2008

**BY: OLWR** 

	STATE WELL	REPORT	
County: HANCOCIL	Part 2	<b></b>	For Office Use Only:
Permit #:	Pump Installer's Comp Mississippi Department of Env		•
Driller: NECALLE WELL	Office of Land and Wat P.O. Box 106	er Resources	
Date completed: 7-15-08	Jackson, MS 3928	9-0631 Well #	<u>K-64</u>
Copy information from block on Part 1	(601)961-521 (601)354-6938		ion:
This part of the report must be complet	الـــ ed by a licensed water well contract	or or a licensed pump installer.	A copy of Part 1 of
report must be attached and both parts	filed with the Department at the ab	ove address within 30 days of we Well Locati	ell completion.
Owner Name: AMAI	Maria	de: Longitu	
10.1.111	8 no. due		
Mailing Address: XSt 479	C	d of Lat/Long (check one): Con	•
		quad, Hand-held GPS	, Survey-grade GPS
City State	$u_{i} (Y_{i}) $	_¼¼ SecT	<u> </u>
	Zip Code Distan	ce Direction Nea	irest Town
Telephone No. 038055-26	176		
	<u> </u>		
Pump Type Circle one		Power Typ	
		Circle one	
Air Lift Jet		Engine Gasoline Engine	e Natural (
Bucket Piston		c Motor Hand	Tractor P
Centrifugal Rotary	Flowing Well Windr	nill Other (specify)	REA
Other (specify):	Horse	Power Rating of Motor:	
- ·	<b>X</b> 1		The Offeet
Date Pump Installed: _2-15-09	Setting	Depth:40	
		: Depth:40	O.Yo
		•	<u></u> OL
	Gallons Per Minute Numb	er of Stages: Method of Measuring	Water Level
Rated Pump Capacity:	Gallons Per Minute Numb	er of Stages: Method of Measuring Circle one	Water Level
Rated Pump Capacity: O	Gallons Per Minute Numb	er of Stages: Method of Measuring Circle one	Water Level
Rated Pump Capacity: O Pump Test Dat Date Well Tested:Fe Static Water Level (A):Fe	Gallons Per Minute Numb	er of Stages: Method of Measuring Circle one	Water Level
Rated Pump Capacity: 10 Pump Test Date Date Well Tested: Static Water Level (A): Fe Pumping Water Level (B): Fe	Gallons Per Minute Numb	er of Stages: Method of Measuring Circle one ne Electric Measuring Li (specify):	Water Level
Rated Pump Capacity: Pump Test Date Date Well Tested: Static Water Level (A):Fe Pumping Water Level (B):Fe Drawdown [(B) – (A)]:Fe	Gallons Per Minute Numb	er of Stages: Method of Measuring Circle one ne Electric Measuring Li (specify): wing well, measured shut in hea	Water Level inc Steel Tape
Rated Pump Capacity: 10 Pump Test Date Date Well Tested: Static Water Level (A): Fe Pumping Water Level (B): Fe	Gallons Per Minute Numb a et Below Land Surface Other et Below Land Surface For flo Gallons Per Minute Well y	er of Stages: Method of Measuring Circle one ne Electric Measuring Li (specify):	inc Steel Tap