

County: HANCOCK
 Permit #: _____
 Driller: NECAISE WELL
 Date drilling completed: 1-8-08

State Well Report
Part 1 - Driller's Log
 Mississippi Department of Environmental Quality
 Office of Land and Water Resources
 P.O. Box 10631
 Jackson, MS 39289-0631
 (601)961-5210
 (601)354-6938 (fax)

For Office Use Only:
 Aquifer: _____
 Well #: K-660
 L. S. Elevation: _____
 E-log #: _____

State Law requires that this report be prepared by the license holder responsible for the work and filed with the Department at the above address within 30 days of completion of drilling of the well or borehole.

Information on Well Owner (Landowner if borehole is not for a water well)	Well or Borehole Location
Owner Name: <u>Garcibayli Thomas</u>	Latitude: _____ Longitude: _____
Mailing Address: <u>1021 E. Chickasaw</u>	Method of Lat/Long (circle one): Conventional Survey, USGS quad, Hand-held GPS, Survey-grade GPS
<u>Bay St Louis MS</u>	_____ 1/4 _____ 1/4 Sec <u>6</u> Twn <u>9S</u> Rng <u>14W</u>
City State Zip Code	Distance Direction Nearest Town
Telephone No. <u>228 255-0276</u>	_____ Miles _____ of _____

Well / Borehole Data

Date drilling started: 1-8-08 Date drilling completed: 1-8-08 Hole depth: 140 Hole diameter: 4"

Location of the source of any surface water used for drilling: HANCOCK COUNTY WATER-SEWER
 Method of dosing and volume of Chlorine used in drilling and development: _____

Logs run (circle all applicable): No log run Electric Gamma Ray Density Sonic Neutron Other: _____
 Name of organization running log(s): _____

Purpose of borehole (check one): Water Well Geotechnical/Geological Investigation _____ Ground Source Heat Pump _____
 Seismic Survey _____ Other (describe) _____

If drilling is not related to water well construction, skip the remainder of this block

Purpose of Well (check one): Home Industrial _____ Public Supply _____ Irrigation _____ Fish Culture _____ Other: _____

If a flowing well, method of flow regulation: Valve _____ Other (describe) _____

Static Water Level: 12 feet above or below (circle one) land surface Date measured: 1-8-08

Method of Measurement (circle one) steel tape electric tape air line other: _____

Well depth: 140 Well grouted to a depth of 10 feet Type of grout (circle one): Neat Cement Bentonite Mix

Casing length: 150 feet Casing diameter: 2" inches Type of casing: PVC

Screen length: 10 feet Screen diameter: 2" inches Type of screen: PVC

Screen slot size: .006 inches Setting depth: From 150 feet to 140 feet

Type of completion (circle all applicable): Gravel packed Underreamed Telescoped Open hole Natural Development
 Other (describe): _____

Top of lap pipe or reduction in casing: _____ feet. *If telescoped or more than one screen, describe on next page*

Form: OLWR-SWR-1A

RECEIVED
 JAN 23 2008
 BY: OLWR

topozone

- [VIEW MAPS](#)
- [GET DATA](#)
- [MY TOPOZONE](#)
- [WEB SERVICES](#)
- [ABOUT US](#)
- [HELP!](#)

Download every USGS Topo Map & Aerial Photograph available here \$9.95

[Map and Photo Info](#)
[Download Topo Images](#)
[Download Photo Images](#)

USGS Topo Maps

- No topo basemap
- 1:24K/25K Topo Maps
- 1:100K Topo Maps
- 1:250K Topo Maps
- Automatic selection

TopoZone Pro

- Shaded Relief
- Street Maps

Aerial Photos

- Color Infrared

Map Size

- Small
- Medium
- Large
- Huge

View Scale

1 : 24,000

Coordinate Format

D/M/S

Map Datum

NAD27


Show target




Bayside Park, USGS Waveland (MS) Topo Map

30° 16' 52"N, 89° 26' 12"W (NAD27)

Elevation 0.0 ft / 0.0 m (USGS NED)

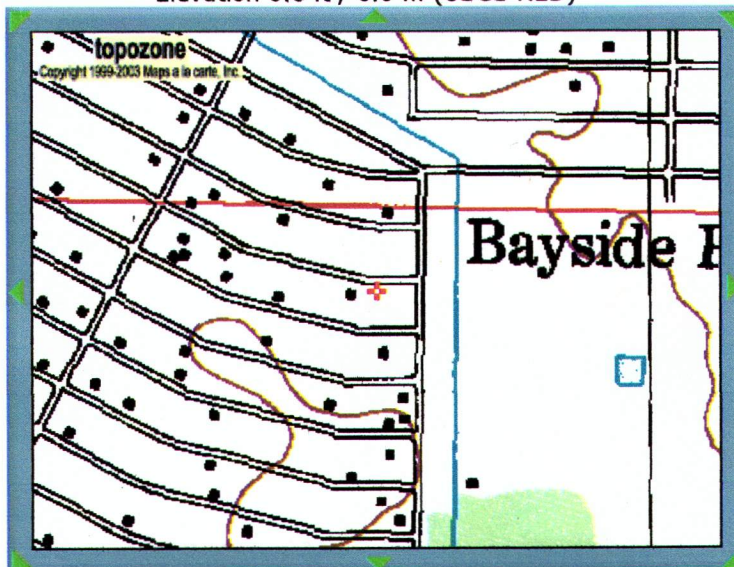

[Print Map](#) | [Download MapPack](#) | [Bookmark Map](#) | [Email Map](#)

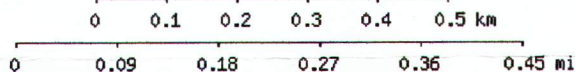

[What's this?](#)

TopoZone.com © 1999-2007 Demand Media, Inc. - All rights reserved.

Use of this site is governed by our [Conditions and Terms of Use](#). We care about your privacy - please read our [Privacy Statement](#).



