

County: hancock
 Permit #: _____
 Driller: Elmer
 Date drilling completed: 1-20-08

State Well Report

Part 1 - Driller's Log

Mississippi Department of Environmental Quality
 Office of Land and Water Resources
 P.O. Box 10631
 Jackson, MS 39289-0631
 (601)961-5210
 (601)354-6938 (fax)

For Office Use Only:
 Aquifer: _____
 Well #: K-731
 L. S. Elevation: _____
 E-log #: _____

State Law requires that this report be prepared by the license holder responsible for the work and filed with the Department at the above address within 30 days of completion of drilling of the well or borehole.

Information on Well Owner (Landowner if borehole is not for a water well)	Well or Borehole Location
Owner Name: <u>Miracle Homes LLC</u>	Latitude: <u>30° 17' 20" N</u> Longitude: <u>89° 25' 29" W</u>
Mailing Address: <u>1211 Miramar St</u> <u>Capelona, FL, 33904</u>	Method of Lat/Long (circle one): <u>07</u> Conventional Survey, <u>55</u> USGS quad, Hand-held GPS, Survey-grade GPS
City: _____ State: _____ Zip Code: _____	USGS quad, Hand-held GPS, Survey-grade GPS <u>SE 1/4 Sec 6 Twn 9S Rng 14W</u>
Telephone No. (<u>239</u>) _____	Distance _____ Miles _____ of _____ Nearest Town _____ <u>6131 Pike, Dyess, MS</u>
Well / Borehole Data	
Date drilling started: <u>1-20-08</u> Date drilling completed: <u>1-20-08</u> Hole depth: <u>140</u> Hole diameter: <u>4 1/2</u>	
Location of the source of any surface water used for drilling: <u>city water</u>	
Method of dosing and volume of Chlorine used in drilling and development: <u>+ 1 gallon ch</u>	
Logs run (circle all applicable): <u>No log run</u> Electric Gamma Ray Density Sonic Neutron Other: _____	
Name of organization running log(s): _____	
Purpose of borehole (check one): Water Well <input checked="" type="checkbox"/> Geotechnical/Geological Investigation _____ Ground Source Heat Pump _____	
Seismic Survey _____ Other (describe) _____	
If drilling is not related to water well construction, skip the remainder of this block	
Purpose of Well (check one): Home <input checked="" type="checkbox"/> Industrial _____ Public Supply _____ Irrigation _____ Fish Culture _____ Other: _____	
If a flowing well, method of flow regulation: Valve _____ Other (describe) _____	
Static Water Level: _____ feet above or below (circle one) land surface Date measured: _____	
Method of Measurement (circle one) <u>steel tape</u> electric tape air line other: _____	
Well depth: <u>140</u> Well grouted to a depth of <u>20</u> feet Type of grout (circle one): Neat Cement <u>Bentonite</u> Mix	
Casing length: <u>120</u> feet Casing diameter: <u>2"</u> inches Type of casing: <u>sch 80</u>	
Screen length: <u>20</u> feet Screen diameter: <u>2"</u> inches Type of screen: <u>sch 80</u>	
Screen slot size: <u>.006</u> inches Setting depth: From <u>120</u> feet to <u>140</u> feet	
Type of completion (circle all applicable): <u>Gravel packed</u> Underreamed Telescoped Open hole Natural Development	
Other (describe): _____	
Top of lap pipe or reduction in casing: _____ feet. <i>If telescoped or more than one screen, describe on next page</i>	

Form: OLWR-SWR-1A


RECEIVED
 MAR 25 2008
 BY: OLWR

K-731

The sketch below only required for water wells

If well telescopes, show depths on sketch.

Ground Level →

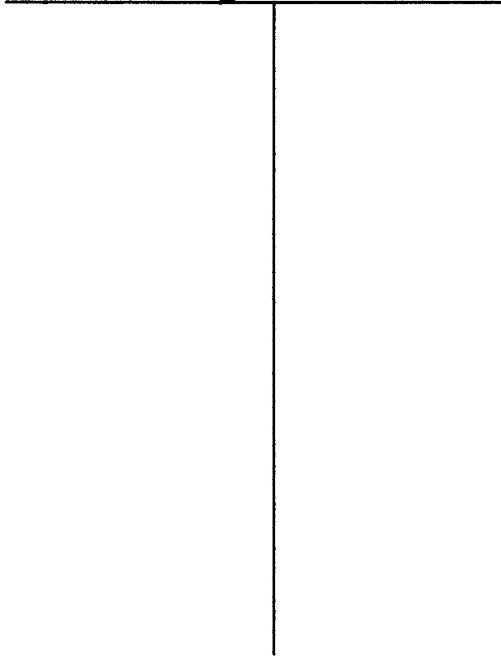

Description of formations encountered must be provided for all wells and boreholes, unless specifically exempted by regulations

Description of Formations Encountered	From (depth)	To (depth)
	Ground Level	
sand	0	15
black sand	16	50
green clay	51	70
gray clay	71	99
white sand	100	119
black sand	120	140

If more than one screen, show location of each on sketch

Sketch the property layout and include the following: 1) the well location; 2) any permanent structures on the property that may aid in locating the well; 3) any roads, power lines, or other items that may aid in locating the property and the well; 4) a north arrow.

Landowner Name: Miracle Home LLC

Form: OLWR-SWR-1A

I certify that the well/borehole was drilled, constructed, and completed in accordance with all applicable requirements of the Mississippi Department of Environmental Quality and the Mississippi Department of Health regulations, if applicable, and state laws.

Bernard Edmondson 0-793

Print Name of Responsible Licensee and License No. Date

Signature of Licensee

RECEIVED
MAR 25 2008
BY: OLWR

STATE WELL REPORT

Part 2

Pump Installer's Completion Report
 Mississippi Department of Environmental Quality
 Office of Land and Water Resources
 P.O. Box 10631
 Jackson, MS 39289-0631
 (601)961-5210
 (601)354-6938 (fax)

County: Hancock
 Permit #: _____
 Driller: Elmer
 Date completed: 1-22-08
Copy information from block on Part 1

For Office Use Only:

Aquifer: _____
 Well #: K-731
 Elevation: _____

This part of the report must be completed by a licensed water well contractor or a licensed pump installer. A copy of Part 1 of the report must be attached and both parts filed with the Department at the above address within 30 days of well completion.

Well Owner Information	Well Location
Owner Name: <u>Miracle homes</u>	Latitude: <u>30° 17.120' N</u> Longitude: <u>089° 25.919' W</u>
Mailing Address: <u>1211 Miramar St</u> <u>Cape Coral FL 33904</u>	Method of Lat/Long (check one): Conventional Survey _____ USGS quad _____, <u>Hand-held GPS</u> , Survey-grade GPS _____ _____ 1/4 _____ 1/4 Sec _____ T _____ R _____
City _____ State _____ Zip Code _____	Distance _____ Direction _____ Nearest Town _____
Telephone No. (____) _____	_____ Miles of <u>6131 Pk St E, by side, MS</u>

Pump Type Circle one	Power Type Circle one
Air Lift <input type="radio"/> <u>Jet</u> <input type="radio"/> Submersible	Diesel Engine <input type="radio"/> Gasoline Engine <input type="radio"/> Natural Gas
Bucket <input type="radio"/> Piston <input type="radio"/> Turbine	<u>Electric Motor</u> <input type="radio"/> Hand <input type="radio"/> Tractor PTO
Centrifugal <input type="radio"/> Rotary <input type="radio"/> Flowing Well	Windmill <input type="radio"/> Other (specify): _____
Other (specify): _____	Horse Power Rating of Motor: <u>1</u>
Date Pump Installed: <u>1-22-08</u>	Setting Depth: _____ feet
Rated Pump Capacity: <u>15</u> Gallons Per Minute	Number of Stages: _____

Pump Test Data	Method of Measuring Water Level Circle one
Date Well Tested: <u>1-22-08</u>	Air Line <input type="radio"/> Electric Measuring Line <input type="radio"/> <u>Steel Tape</u>
Static Water Level (A): <u>10</u> Feet Below Land Surface	Other (specify): _____
Pumping Water Level (B): <u>18</u> Feet Below Land Surface	For flowing well, measured shut in head: _____ feet
Drawdown [(B) - (A)]: <u>8</u> Feet Below Land Surface	Well yielded _____ GPM with a drawdown of _____ feet after _____ hours of pumping
Test Pumping Rate: <u>14</u> Gallons Per Minute	
Duration of Pump Test (minimum 4 hours): <u>4</u> hours	

I HEREBY CERTIFY that the above statements are true to the best of my knowledge.

Bernard Edmonson 0-793 _____
 Print Name of Pump Installer and License No. (if applicable) Signature of Pump Installer

Form: OLWR-SWR-1B

RECEIVED

MAR 25 2008

BY: OLWR