
County has cark Permit # Driller Emes Date drilling completed 2-21-08	Well Driller Report and Well Log Mississippi Department of Environmental Quality Office of Land and Water Resources P.O. Box 10631 Jackson, MS 39289-0631 (601)961-5210		For Office Use Only: Aquifer Well # K-748 I S Elevation: E-log #
State Law rooming the end		6938 (fax)	
State Law requires that this t 30 days of completion of drill Well Owner Infor	eport be prepared by the d ing of the well.	riller in detail and filed with	the Department within
Owner Name Car HCast Con Mailing Address: 1200 Beuch	to Grayp LLC	Latitude: 30 ° 17 503 30 Method of Lat/Long (circle or USGS guad Hand-held	Location 2" Longitude 089° 26 45 j" 27 Ane): Conventional Survey, 27 GPS, Survey-grade GPS Twn 25 Rng 14 w
Telephone No. ()	I	Miles	Nearest Town
		6189 Itawa	mba
Purpose of Well (circle one Flome Date well drilling started:	Industrial Public Supply 21-08 Date Valve Other (t above or below (circle one) steel tape electric tape depth:O Bentonite Mix asing diameter:Mix asing diameter:G creen diameter:G S Setting depth: From e): Gravel packed Under Other (describe):	Irrigation Fish Culture well drilling completed:describe) land surface Date measure air line other: Well grouted to a depth of Well grouted to a depth of finches Type of casing inches Type of screen: feet to freeamed Telescoped Op	Other: $2-21-08$ ed: $2-21-08$ f 20 feet $5h40^{\circ}$ 1.0 feet ven hole Natural Development
Top of lap pipe or reduction in casing:	feet. If te	lescoped or more than one s	creen, describe on back of page
Logs run (circle all applicable): No log Name of organization running log(s): I certify that the well was drilled, constructed, Environmental Quality and/or the Mississippi	Electric Gamma Ray	Density Sonic Neutron	Other:
B. Len	- / 0 -	h	MAR 2 5 2008
Print Name of Water Well Contractor ar	2 2 93 ad License No		BY: OLWB
If well telescopes please sketch below ar	d show depths	Signature of	Water Well Contractor

	·····		ELL REPORT art 2			
County hancock			Completion Report	For Office	Use Only:	
atc completed 2-21-08 Office of Land at		t of Environmental Quality nd Water Resources Box 10631	Aquiter Well # K Elevation	748		
		(601) (601)25	IS 39289-0631 961-5210 4-6938 (fax)			
			detail and filed with the D list be attached to this repo	epartment within 3	0 days of the	
****	Owner inforn	tation	W	ell Location		
Owner Name: Gulf Coat Cont Gray			Latitude: 30°/7503N Longitude: 089, 26,451			
Mailing Address:			Method of Lat/Long (circle one): Conventional Survey,			
120	Beach	ns, suit 904	USGS quad, H	and-held GPS. Sur	vey-grade GPS	
City	Sta	AT Zip Code		Twn	Rng	
			Distance Directio	n Nearest To	wn	
Telephone No. ()			GI89 Las	Ztawam	ba	
	Pump Type Circle one			Power Type Circle one		
Air Lift ~	Jet	Submersible	Diesel Engine Ga	soline Engine	Natural Ga	
Bucket	Piston	Turbine	Rectric Motor Ha	and	Tractor PT	
Centrifugal	Rotary	Flowing Well	Windmill Ot	her (specify):		
Other (specify):			Horse Power Rating of M	otor: <u>1</u>		
Date Pump Installed:	• •	8	Setting Depth:8	<u>.</u>	feet	
Rated Pump Capacity: _	20	Gallons Per Minute	Number of Stages:	····		
Pump Test Data Date Well Tested: 2-22-08			Method of N	Measuring Water Le Circle one	vel	
Static Water Level (A):	1 -	Feet Below Land Surface	Air Line Electric	Measuring Line	Steel Tape	
Pumping Water Level (~ ~	Feet Below Land Surface	Other (specify):			
Drawdown [(B) = (A)]:		Feet Below Land Surface	For flowing well, measure	ed shut in head-	r	
Test Pumping Rate: 20 Gallons Per Minute			For flowing well, measured shut in head: feet Well yielded GPM_with a drawdown of			
Duration of Pump Fest		ours): <u> </u>	feet aft			
THEREDY CERTIFY (hat the above s	tatements are true to the be $-7 \rho n$			CEIVED	
Print Name of Pump In	staller and Lice	nse No. (if applicable)	Signature of Pump Ir			
				——————————————————————————————————————	R 2 5 2008 OLWF	

K-748

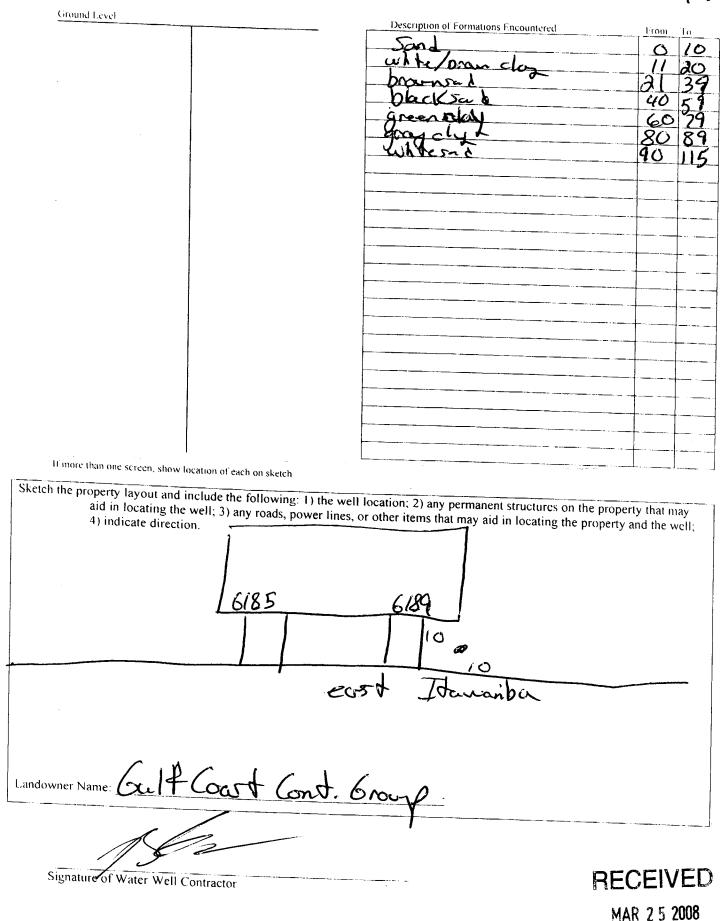

:

BY: OLWR