County: Hancock	Part 1 – Driller's Log	For Office Use Only:
County/ TANK BOOD	Mississippi Department of Environmental Quality	Aquifer:
Permit #:	Office of Land and Water Resources	K-794
Driller: 0-785	P.O. Box 10631	Well #:
	Jackson, MS 39289-0631	L. S. Elevation:
Date drilling completed: 3-27-0	(601)961-5210	
	(601)354-6938 (fax)	E-log #:

10

.

State Law requires that this report be prepared by the license holder responsible for the work and filed with the Department at the above address within 30 days of completion of drilling of the well or borehole.

Information on Well Owner	Well or Borehole Location
(Landowner if borehole is not for a water well)	20 16 662
Owner Name Miscissippi United Melledit	Latitude: 30 ° 19 ' 053' Longitude: 89° 24 ' 084"
Owner Name Mississippi United Methodist Disaster Response	Method of Lat/Long (circle one): Conventional Survey,
Mailing Address:	
5023 Kennon St.	USGS quad, Hand-held GPS, urvey-grade GPS
Reinori Sti	1/4 Sec_28 Twn 85 Rng 19 hr
Bay St. Louis MS. 39576	7474 Sec I Wh Rhg
City State Zip Code	Distance Direction Nearest Town
TIL 1 270 11:2 DECI	Miles of
Telephone No. (228) 463-8951	
Patricia Jones Well / Bore	hole Deta
Date drilling started: 3-27 Date drilling completed: 3-27	Hole depth: <u>200</u> Hole diameter: <u>5"</u>
Location of the second of the second s	
Location of the source of any surface water used for drilling: Method of dosing and volume of Chlorine used in drilling and devel	
Logs run (circle all applicable): No log run Electric Gamma Ray	Density Sonic Neutron Other:
Name of organization running log(s):	-
Purpose of borehole (check one): Water Well Geotechnical/Geol	
Turpose of borenoie (eneck one). water wen Geotechnical/Geot	ogical Investigation Ground Source Heat Pump
Seismic SurveyOther (describe	)
If drilling is not related to water well constructio	n, skip the remainder of this block
Purpose of Well (check one): Home Industrial Public Supply	/IrrigationFish CultureOther:
If a flowing well, method of flow regulation: Valve O	ther (describe)
Static Water Level: feet above or below (bircle one) I	and surface Date measured: <u>3-27-88</u>
Method of Measurement (circle one)	oir line other
Method of Measurement (circle one) steel tape electric tape	air nne otner:
Well depth: 200 Well grouted to a depth of 15 feet Type	of grout (circle one). Neat Cement Bentonite Mix
Casing length: <u>190</u> feet Casing diameter: <u>2</u>	inches Type of casing:
Screen length:feet Screen diameter:2	inches Type of screen: AVI
Screen slot size: inches Setting depth: From	190 feet to 200 feet
Type of completion (circle all applicable): Gravel packed Under	reamed Telescoped Open hole Natural Development
Other (describe):	
Top of lap pipe or reduction in casing:feet. If tel	lescoped or more than one screen, describe on next page
	E Olline output
	Form: OLWR-SWR-1A

APR 2 9 2008 BY: OLWR


K - 794

The sketch below only required for water wells

If well telescopes, show depths on sketch. Ground Level\_\_\_\_\_ Description of formations encountered must be provided for all wells and boreholes, unless specifically exempted by regulations

n (depth) ound Level /S GO /P O	15 90 180 200
90	180
691	200
	1
	+

If more than one screen, show location of each on sketch

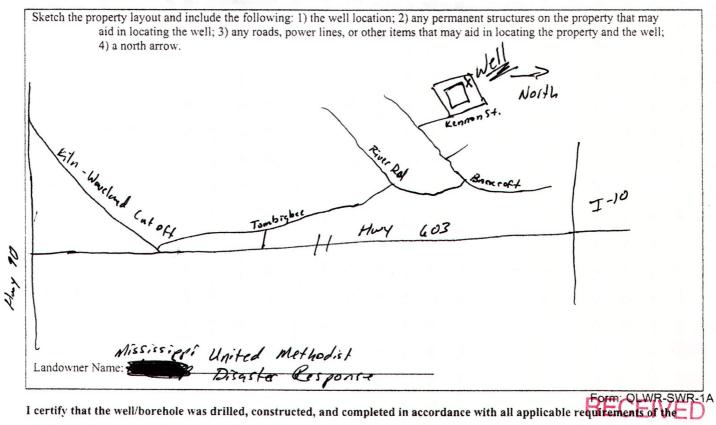

Mississippi Department of Environmental Quality and the Mississippi Department of Health regulations, if applicable, and state

MALVIN WAGNON 0-785 3-27-08 Mal-

Wagpo Signature of Licensee

Print Name of Responsible Licensee and License No.

Date

County: Hancock	Part 2	
	Pump Installer's Completion Report	For Office Use Only:
Permit #:	Mississippi Department of Environmental Quality Office of Land and Water Resources	Aquifer:
Driller: 0-785	P.O. Box 10631	V 794
Date completed: 3-28-08	Jackson, MS 39289-0631	Well #: K- 799
Copy information from block on Part 1	(601)961-5210 (601)354-6938 (fax)	Elevation:
	]	L
This part of the report must be completed report must be attached and both parts fi	by a licensed water well contractor or a licensed pump led with the Department at the above address within 30	installer. A copy of Part 1 of the
Wall Owney Informa	tion	ell Location
Mississippi United Dwner Name: Disgeter Ken	Methodist 20°-19 NSZ	Longitude: 89 - 24.08
		Longitude: 07 - 27.00
lailing Address: 5023 Ken	Method of Lat/Long (check	one): Conventional Survey,
Suds Ken	non Sti	d GPS, Survey-grade GPS_
R		u ors, survey-grade ors_
Bay 54. Louis MS. City State		TR
City State	Distance Direction	Nearest Town
228 117 000		
elephone No. (22P) 463 - 89 Patricis Tor	Miles	of
Pump Type		ower Type
Circle one		Circle one
r Lift Jet	Submersible Diesel Engine Gasol	ine Engine Natural Gas
ucket Piston	Turbine Electric Motor Hand	Tractor DTO
	Hand	Tractor PTO
entrifugal Rotary	Flowing Well Windmill Other	(specify):
ther (specify):	Horse Power Rating of Moto	or: /
		or:/
te Pump Installed:	Setting Depth:	feet
e Pump Installed:	Setting Depth:	feet
te Pump Installed:	Setting Depth: _Gallons Per Minute Number of Stages:	feet
	Setting Depth: _Gallons Per Minute Number of Stages: Method of M	feet
ate Pump Installed: ated Pump Capacity: Pump Test Data ate Well Tested: 3-29	Setting Depth: _Gallons Per Minute Number of Stages: Method of M	feet easuring Water Level Circle one
ate Pump Installed: ated Pump Capacity: Pump Test Data ate Well Tested: 3-29	Setting Depth: _Gallons Per Minute Number of Stages:  Method of M  Below Land Surface	feetf
ate Pump Installed: ated Pump Capacity: Pump Test Data ate Well Tested: tatic Water Level (A):OFeet	Setting Depth: _Gallons Per Minute Number of Stages: Method of M  Below Land Surface Other (crecify):	feetf
ate Pump Installed: ated Pump Capacity: Pump Test Data ate Well Tested: atic Water Level (A): IDFeet Imping Water Level (B): Feet	Setting Depth: _Gallons Per Minute Number of Stages: Method of M Below Land Surface Other (specify):	feet
ate Pump Installed: ated Pump Capacity: Pump Test Data bate Well Tested: ? - 29 tatic Water Level (A): Feet umping Water Level (B): 30 Feet	Setting Depth: _Gallons Per Minute Number of Stages: Method of M Below Land Surface Other (specify):	feetf
ate Pump Installed:ated Pump Capacity:	Setting Depth: _Gallons Per Minute Number of Stages: Method of M Below Land Surface Other (specify): Below Land Surface For flowing well, measured s	feetfeetfeet Circle one rasuring Line Steel Tapefeetfeet
ate Pump Installed: ated Pump Capacity: Pump Test Data pate Well Tested: tatic Water Level (A): umping Water Level (B): Feet prawdown [(B) – (A)]: Feet	Setting Depth: _Gallons Per Minute Number of Stages: Method of M Air Line Electric Me Below Land Surface Other (specify): Below Land Surface For flowing well, measured s _Gallons Per Minute Well yielded	feet

APR 2 9 2008 BY: OLWR