

County: Hancock
 Permit #: _____
 Driller: Necaise Well Service
 Date drilling completed: 6-5-08

State Well Report
Part 1 - Driller's Log
 Mississippi Department of Environmental Quality
 Office of Land and Water Resources
 P.O. Box 2309
 Jackson, MS 39225
 (601)961-5210
 (601)360-0525 fax)

For Office Use Only:
 Aquifer: _____
 Well #: K-826
 L. S. Elevation: _____
 E-log #: _____

State Law requires that this report be prepared by the license holder responsible for the work and filed with the Department at the above address within 30 days of completion of drilling of the well or borehole.

Information on Well Owner <i>(Landowner if borehole is not for a water well)</i>	Well or Borehole Location
Owner Name: <u>Blue Oak Construction</u>	Latitude: _____ Longitude: _____
Mailing Address: <u>6131 E. Maroon St</u> <u># 80070</u> <u>Bay St Louis, MS</u>	Method of Lat/Long (circle one): Conventional Survey, USGS quad, Hand-held GPS, Survey-grade GPS
City: _____ State: _____ Zip Code: _____	____ 1/4 ____ 1/4 Sec <u>7</u> Twn <u>9S</u> Rng <u>14W</u>
Telephone No. <u>238-549-7718</u>	Distance _____ Miles Direction _____ of Nearest Town <u>Lakeshore</u>

Well / Borehole Data

Date drilling started: 6-5-08 Date drilling completed: 6-5-08 Hole depth: 140 Hole diameter: 4"

Location of the source of any surface water used for drilling: Abbeville City Water & Sewer

Method of dosing and volume of Chlorine used in drilling and development: _____

Logs run (circle all applicable): No log run Electric Gamma Ray Density Sonic Neutron Other: _____

Name of organization running log(s): _____

Purpose of borehole (check one): Water Well Geotechnical/Geological Investigation _____ Ground Source Heat Pump _____

Seismic Survey _____ Other (describe) _____

If drilling is not related to water well construction, skip the remainder of this block

Purpose of Well (check one): Home Industrial _____ Public Supply _____ Irrigation _____ Fish Culture _____ Other: _____

If a flowing well, method of flow regulation: Valve _____ Other (describe) _____

Static Water Level: 12 feet above on below (circle one) land surface Date measured: 6-5-08

Method of Measurement (circle one) steel tape electric tape air line other: _____

Well depth: 140 Well grouted to a depth of 10 feet Type of grout (circle one): Neat Cement Bentonite Mix

Casing length: 130 feet Casing diameter: 2" inches Type of casing: PVC

Screen length: 10 feet Screen diameter: 2" inches Type of screen: PVC

Screen slot size: .006 inches Setting depth: From 130 feet to 140 feet

Type of completion (circle all applicable): Gravel packed Underreamed Telescoped Open hole Natural Development

Other (describe): _____

Top of lap pipe or reduction in casing: _____ feet. *If telescoped or more than one screen, describe on next page*

Form: OLWR-SWR-1A

RECEIVED
 JUN 12 2008
 BY: OLWR

K-826

The sketch below only required for water wells

If well telescopes, show depths on sketch.


Ground Level 

Description of formations encountered must be provided for all wells and boreholes, unless specifically exempted by regulations

Description of Formations Encountered	From (depth) To (depth)	
	Ground Level	
MUD	0	30
SAND	30	70
SCTAN	70	100
SAND	100	140

If more than one screen, show location of each on sketch

Sketch the property layout and include the following: 1) the well location; 2) any permanent structures on the property that may aid in locating the well; 3) any roads, power lines, or other items that may aid in locating the property and the well; 4) a north arrow.

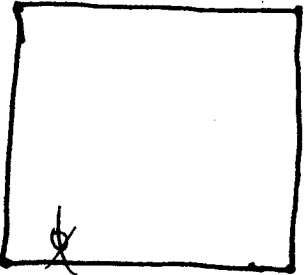


Landowner Name:

Blue Oak Construction

I certify that the well/borehole was drilled, constructed, and completed in accordance with all applicable requirements of the Mississippi Department of Environmental Quality and the Mississippi Department of Health regulations, if applicable, and state laws.

Form: OLWR-SWR-1A

Robert Necaise 0-660 4-5-08

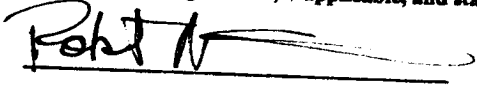

Print Name of Responsible Licensee and License No.

Date

Signature of Licensee

RECEIVED

JUN 12 2008

BY: OLWR

STATE WELL REPORT

Part 2

Pump Installer's Completion Report
 Mississippi Department of Environmental Quality
 Office of Land and Water Resources
 P.O. Box 12309
 Jackson, MS 39225
 (601)961-5210
 (601)360-0535

County: Hancock
 Permit #: _____
 Driller: Necaise Well Service
 Date completed: 7-12-08
Copy information from block on Part 1

For Office Use Only:

Aquifer: _____
 Well #: K-826
 Elevation: _____

This part of the report must be completed by a licensed water well contractor or a licensed pump installer. A copy of Part 1 of the report must be attached and both parts filed with the Department at the above address within 30 days of well completion.

Well Owner Information	Well Location
Owner Name: <u>Blue Oak Construction</u>	Latitude: _____ Longitude: _____
Mailing Address: <u>4131 E Maroon St</u> <u># 80072</u> <u>Bay St Louis, MS</u>	Method of Lat/Long (check one): Conventional Survey _____ USGS quad _____ Hand-held GPS _____ Survey-grade GPS _____ _____ 1/4 _____ 1/4 Sec <u>7</u> T <u>9</u> SR <u>14</u> W
City _____ State _____ Zip Code _____	Distance _____ Direction _____ Nearest Town _____
Telephone No. <u>239-549-7718</u>	<u>2</u> Miles <u>W</u> of <u>Lake Shore</u>

Pump Type Circle one	Power Type Circle one
Air Lift _____ Jet _____ Submersible _____	Diesel Engine _____ Gasoline Engine _____ Natural Gas _____
Bucket _____ Piston _____ Turbine _____	<u>Electric Motor</u> _____ Hand _____ Tractor PTO _____
<u>Centrifugal</u> _____ Rotary _____ Flowing Well _____	Windmill _____ Other (specify): _____
Other (specify): _____	Horse Power Rating of Motor: <u>1</u>
Date Pump Installed: <u>7-12-08</u>	Setting Depth: <u>40'</u> feet
Rated Pump Capacity: <u>10</u> Gallons Per Minute	Number of Stages: <u>1</u>

Pump Test Data	Method of Measuring Water Level Circle one
Date Well Tested: _____	Air Line _____ Electric Measuring Line _____ <u>Steel Tape</u>
Static Water Level (A): _____ Feet Below Land Surface	Other (specify): _____
Pumping Water Level (B): _____ Feet Below Land Surface	For flowing well, measured shut in head: _____ feet
Drawdown [(B) - (A)]: _____ Feet Below Land Surface	Well yielded _____ GPM with a drawdown of _____ feet after _____ hours of pumping
Test Pumping Rate: _____ Gallons Per Minute	
Duration of Pump Test (minimum 4 hours): _____ hours	

I HEREBY CERTIFY that the above statements are true to the best of my knowledge.

Robert Necaise 0-660 _____
 Print Name of Pump Installer and License No. (if applicable) Signature of Pump Installer

Form: OLWR-SWR-1B

RECEIVED

AUG 13 2008

BY: OLWR