

County: Hancock
 Permit #: _____
 Driller: Garry Lestz
 Date drilling completed: 6-24-08

State Well Report
Part 1 - Driller's Log

Mississippi Department of Environmental Quality
 Office of Land and Water Resources
 P.O. Box 10631
 Jackson, MS 39289-0631
 (601)961-5210
 (601)354-6938 (fax)

For Office Use Only:
 Aquifer: _____
 Well #: K-854
 L. S. Elevation: _____
 E-log #: _____

State Law requires that this report be prepared by the license holder responsible for the work and filed with the Department at the above address within 30 days of completion of drilling of the well or borehole.

Information on Well Owner (Landowner if borehole is not for a water well)	Well or Borehole Location
Owner Name: <u>Osceola Southern Homes</u>	Latitude: <u>30.19.407</u> Longitude: <u>89.23.658</u>
Mailing Address: <u>1041 Rd 55L</u>	Method of Lat/Long (circle one): Conventional Survey, <u>39</u>
<u>Bay St Louis</u> MS <u>39520</u>	USGS quad: <u>Hand-held GPS</u> Survey-grade GPS
City State Zip Code	<u>NE 1/4 NE 1/4</u> Sec <u>28</u> Twn <u>85</u> Rng <u>14W</u>
Telephone No. () _____	Distance Direction Nearest Town <u>3</u> Miles <u>N</u> of <u>Waveland</u>

Well / Borehole Data

Date drilling started: 6-24-08 Date drilling completed: 6-24-08 Hole depth: 150 Hole diameter: 5

Location of the source of any surface water used for drilling: Waveland City Water

Method of dosing and volume of Chlorine used in drilling and development: _____

Logs run (circle all applicable): No log run Electric Gamma Ray Density Sonic Neutron Other: _____

Name of organization running log(s): _____

Purpose of borehole (check one): Water Well Geotechnical/Geological Investigation _____ Ground Source Heat Pump _____

Seismic Survey _____ Other (describe) _____

If drilling is not related to water well construction, skip the remainder of this block

Purpose of Well (check one): Home Industrial _____ Public Supply _____ Irrigation _____ Fish Culture _____ Other: _____

If a flowing well, method of flow regulation: Valve N/A Other (describe) _____

Static Water Level: 10 feet above or below (circle one) land surface Date measured: 6-21-08

Method of Measurement (circle one) steel tape electric tape air line other: _____

Well depth: 147 Well grouted to a depth of 10 feet Type of grout (circle one): Neat Cement Bentonite Mix

Casing length: 127 feet Casing diameter: 2 inches Type of casing: PVC

Screen length: 20 feet Screen diameter: 2 inches Type of screen: PVC

Screen slot size: 6 inches Setting depth: From 127 feet to 147 feet

Type of completion (circle all applicable): Gravel packed Underreamed Telescoped Open hole Natural Development

Other (describe): _____

Top of lap pipe or reduction in casing: _____ feet. *If telescoped or more than one screen, describe on next page*

Form: OLWR-SWR-1A

3160 15th St


RECEIVED
 JUL 01 2008
 BY: OLWR

K-854

The sketch below only required for water wells

If well telescopes, show depths on sketch.

Ground Level →

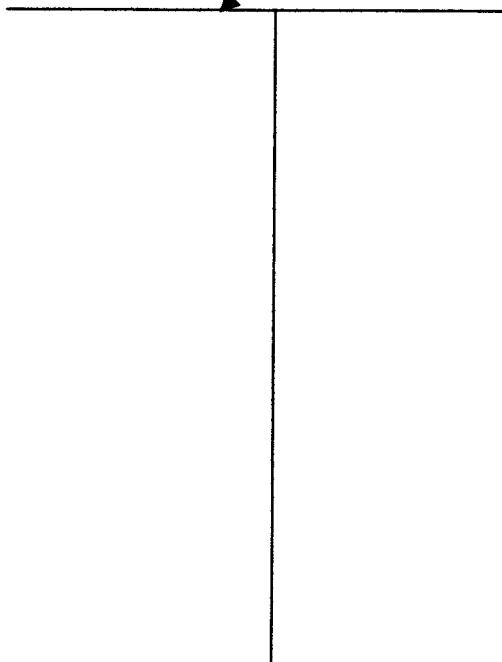

Description of formations encountered must be provided for all wells and boreholes, unless specifically exempted by regulations

Description of Formations Encountered	From (depth)	To (depth)
Clay	Ground Level	10
Sand	10	40
Clay	40	60
Sand Clay	60	75
Clay	75	100
Sand Clay	100	130
Sand	130	150

If more than one screen, show location of each on sketch

Sketch the property layout and include the following: 1) the well location; 2) any permanent structures on the property that may aid in locating the well; 3) any roads, power lines, or other items that may aid in locating the property and the well; 4) a north arrow.

Landowner Name: _____

Form: OLWR-SWR-1A

I certify that the well/borehole was drilled, constructed, and completed in accordance with all applicable requirements of the Mississippi Department of Environmental Quality and the Mississippi Department of Health regulations, if applicable, and state laws.

Print Name of Responsible Licensee and License No.

Date

Signature of Licensee

RECEIVED
JUL 01 2008
BY: OLWR

STATE WELL REPORT

Part 2

Pump Installer's Completion Report
 Mississippi Department of Environmental Quality
 Office of Land and Water Resources
 P.O. Box 10631
 Jackson, MS 39289-0631
 (601)961-5210
 (601)354-6938 (fax)

County: Hancock
 Permit #: _____
 Driller: Garry Lentz
 Date completed: 6-24-08
Copy information from block on Part 1

For Office Use Only:

Aquifer: _____
 Well #: K-854
 Elevation: _____

This part of the report must be completed by a licensed water well contractor or a licensed pump installer. A copy of Part 1 of the report must be attached and both parts filed with the Department at the above address within 30 days of well completion.

Well Owner Information	Well Location
Owner Name: <u>OCEOLA SOUTHERN HOMES</u>	Latitude: <u>30 19 427</u> Longitude: <u>089 23 658</u>
Mailing Address: <u>3160 15th ST,</u>	Method of Lat/Long (check one): Conventional Survey _____
<u>Bay St. Louis MS.</u>	USGS quad <u>Hand-held GPS</u> Survey-grade GPS _____
City State Zip Code	_____ 1/4 _____ 1/4 Sec _____ T _____ R _____
Telephone No. () _____	Distance _____ Direction _____ Nearest Town _____
	_____ Miles _____ of _____

Pump Type Circle one	Power Type Circle one
Air Lift Jet Submersible	Diesel Engine Gasoline Engine Natural Gas
Bucket Piston Turbine	<u>Electric Motor</u> Hand Tractor PTO
Centrifugal Rotary Flowing Well	Windmill Other (specify): _____
Other (specify): <u>SHALLOW Well pumps (x2)</u>	Horse Power Rating of Motor: <u>1 HP</u>
Date Pump Installed: <u>7-11-08</u>	Setting Depth: <u>30</u> feet
Rated Pump Capacity: <u>12.6</u> Gallons Per Minute	Number of Stages: _____

Pump Test Data	Method of Measuring Water Level Circle one
Date Well Tested: _____	Air Line <u>Electric Measuring Line</u> Steel Tape
Static Water Level (A): <u>12</u> Feet Below Land Surface	Other (specify): _____
Pumping Water Level (B): <u>30</u> Feet Below Land Surface	For flowing well, measured shut in head: _____ feet
Drawdown [(B) - (A)]: <u>18</u> Feet Below Land Surface	Well yielded _____ GPM with a drawdown of _____
Test Pumping Rate: _____ Gallons Per Minute	_____ feet after _____ hours of pumping
Duration of Pump Test (minimum 4 hours): _____ hours	

I HEREBY CERTIFY that the above statements are true to the best of my knowledge.

Print Name of Pump Installer and License No. (if applicable) _____ Signature of Pump Installer _____

Form: OLWR-SWR-1B

RECEIVED

JUL 29 2008

BY: OLWR

~~3160 15th St~~