

Part 2 never received 3/13

County: Hancock
 Permit #: _____
 Driller: Necoise Well Service
 Date drilling completed: 8-14-08

State Well Report

Part 1 - Driller's Log

Mississippi Department of Environmental Quality
 Office of Land and Water Resources
 P.O. Box 2309
 Jackson, MS 39225
 (601)961-5210
 (601)360-0522 fax

For Office Use Only:
 Aquifer: _____
 Well #: K-873
 L. S. Elevation: _____
 E-log #: _____

State Law requires that this report be prepared by the license holder responsible for the work and filed with the Department at the above address within 30 days of completion of drilling of the well or borehole.

Information on Well Owner <i>(Landowner if borehole is not for a water well)</i>	Well or Borehole Location
Owner Name: <u>William Thomas</u>	Latitude: <u>30° 17' 40"</u> Longitude: <u>89° 26' 05"</u>
Mailing Address: <u>1004 W. DeLoatch</u>	Method of Lat/Long (circle one): Conventional Survey, _____
<u>Bay St Louis, MS</u>	USGS quad, Hand-held GPS, Survey-grade GPS
City State Zip Code	NW ¼ NE ¼ Sec <u>6</u> Twn <u>9 S</u> Rng <u>14 W</u>
Telephone No. <u>228 831-8066</u>	Distance Direction Nearest Town
	<u>2</u> Miles <u>N</u> of <u>Sakonville</u>

Well / Borehole Data

Date drilling started: 8-14-08 Date drilling completed: 8-14-08 Hole depth: 110' Hole diameter: 5"

Location of the source of any surface water used for drilling: Abbeville City Water & Sewer

Method of dosing and volume of Chlorine used in drilling and development: _____

Logs run (circle all applicable): No log run Electric Gamma Ray Density Sonic Neutron Other: _____

Name of organization running log(s): _____

Purpose of borehole (check one): Water Well Geotechnical/Geological Investigation _____ Ground Source Heat Pump _____

Seismic Survey _____ Other (describe) _____

If drilling is not related to water well construction, ship the remainder of this block

Purpose of Well (check one): Home Industrial _____ Public Supply _____ Irrigation _____ Fish Culture _____ Other: _____

If a flowing well, method of flow regulation: Valve _____ Other (describe) _____

Static Water Level: 12 feet above on below (circle one) land surface Date measured: 8-14-08

Method of Measurement (circle one) steel tape electric tape air line other: _____

Well depth: 110 Well grouted to a depth of 10 feet Type of grout (circle one): Neat Cement Bentonite Mix

Casing length: 100 feet Casing diameter: 3 x 2 inches Type of casing: PVC

Screen length: 10 feet Screen diameter: 2" inches Type of screen: PVC

Screen slot size: .006 inches Setting depth: From 100 feet to 110 feet

Type of completion (circle all applicable): Gravel packed Underreamed Telescoped Open hole Natural Development

Other (describe): _____

Top of lap pipe or reduction in casing: _____ feet. *If telescoped or more than one screen, describe on next page*

Form: OLWR-SWR-1A

RECEIVED
 OCT 02 2008
 BY: OLWR

K-873

The sketch below only required for water wells

If well telescopes, show depths on sketch.



Ground Level 

Description of formations encountered must be provided for all wells and boreholes, unless specifically exempted by regulations

Description of Formations Encountered	From (depth)	To (depth)
	Ground Level	
MUD	0	20
SAND	20	60
B. CLAY	60	90
SAND	90	110

If more than one screen, show location of each on sketch

Sketch the property layout and include the following: 1) the well location; 2) any permanent structures on the property that may aid in locating the well; 3) any roads, power lines, or other items that may aid in locating the property and the well; 4) a north arrow.

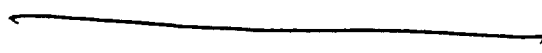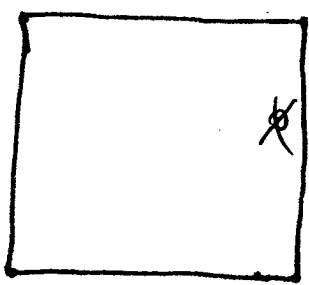

Landowner Name: Gusman Adams

Form: OLWR-SWR-1A

I certify that the well/borehole was drilled, constructed, and completed in accordance with all applicable requirements of the Mississippi Department of Environmental Quality and the Mississippi Department of Health regulations, if applicable, and state laws.

Robert Necaize 0-660
Print Name of Responsible Licensee and License No.

8-14-08
Date

Robert Necaize
Signature of Licensee

RECEIVED
OCT 02 2008
BY: OLWR