

# State Well Report

## Part 1 - Driller's Log

Mississippi Department of Environmental Quality  
Office of Land and Water Resources  
P.O. Box 10631  
Jackson, MS 39289-0631  
(601)961-5210  
(601)354-6938 (fax)

County: Hancock  
 Permit #: \_\_\_\_\_  
 Driller: 0-785  
 Date drilling completed: 2-19-09

For Office Use Only:

Aquifer: \_\_\_\_\_  
 Well #: K-584  
 L. S. Elevation: \_\_\_\_\_  
 E-log #: \_\_\_\_\_

*State Law requires that this report be prepared by the license holder responsible for the work and filed with the Department at the above address within 30 days of completion of drilling of the well or borehole.*

Information on Well Owner <small>(Landowner if borehole is not for a water well)</small>	Well or Borehole Location
Owner Name: <u>Waterford Construction</u>	Latitude: <u>30° 16' 632"</u> Longitude: <u>89° 26' 628"</u> <span style="margin-left: 150px;"><u>38</u></span> <span style="margin-left: 150px;"><u>38</u></span>
Mailing Address: <u>7011</u>	Method of Lat/Long (circle one): Conventional Survey, <u>38</u>
<u>W. Marion</u>	USGS quad: <u>Hand-held GPS</u> , Survey-grade GPS
<u>Bay St. Louis</u> <u>Ms.</u> <u>39520</u>	<u>Sw</u> 1/4 <u>Nw</u> 1/4 Sec <u>7</u> Twn <u>9s</u> Rng <u>14w</u>
City State Zip Code	Distance Direction Nearest Town _____ Miles _____ of _____
Telephone No. (____) <u>Ø</u>	

**Well / Borehole Data**

Date drilling started: 2-19 Date drilling completed: 2-19 Hole depth: 170' Hole diameter: 5"

Location of the source of any surface water used for drilling: \_\_\_\_\_  
 Method of dosing and volume of Chlorine used in drilling and development: \_\_\_\_\_

Logs run (circle all applicable): No log run  Electric  Gamma Ray  Density  Sonic  Neutron  Other: \_\_\_\_\_  
 Name of organization running log(s): \_\_\_\_\_

Purpose of borehole (check one): Water Well   Geotechnical/Geological Investigation \_\_\_\_\_ Ground Source Heat Pump \_\_\_\_\_  
 Seismic Survey \_\_\_\_\_ Other (describe) \_\_\_\_\_

***If drilling is not related to water well construction, skip the remainder of this block***

Purpose of Well (check one): Home   Industrial \_\_\_\_\_ Public Supply \_\_\_\_\_ Irrigation \_\_\_\_\_ Fish Culture \_\_\_\_\_ Other: \_\_\_\_\_

If a flowing well, method of flow regulation: Valve \_\_\_\_\_ Other (describe) \_\_\_\_\_

Static Water Level: 15 feet above below (circle one) land surface Date measured: 2-19-09

Method of Measurement (circle one) steel tape electric tape air line other: \_\_\_\_\_

Well depth: 170 Well grouted to a depth of 10 feet Type of grout (circle one): Neat Cement Bentonite Mix

Casing length: 160 feet Casing diameter: 2 inches Type of casing: PVC

Screen length: 10 feet Screen diameter: 2 inches Type of screen: PVC

Screen slot size: .006 inches Setting depth: From 160 feet to 170 feet

Type of completion (circle all applicable): Gravel packed Underreamed Telescoped Open hole Natural Development  
 Other (describe): \_\_\_\_\_

Top of lap pipe or reduction in casing: \_\_\_\_\_ feet. *If telescoped or more than one screen, describe on next page*

Form: OLWR-SWR-1A

RECEIVED  
MAY 13 2009  
BY: OLWR

K. 884

The sketch below only required for water wells

If well telescopes, show depths on sketch.


Ground Level →

Description of formations encountered must be provided for all wells and boreholes, unless specifically exempted by regulations

Description of Formations Encountered	From (depth)	To (depth)
Clay	Ground Level	15
Sand	15	60
Clay	60	110
Sand	110	130
Clay	130	155
Sand	155	170

If more than one screen, show location of each on sketch

Sketch the property layout and include the following: 1) the well location; 2) any permanent structures on the property that may aid in locating the well; 3) any roads, power lines, or other items that may aid in locating the property and the well; 4) a north arrow.

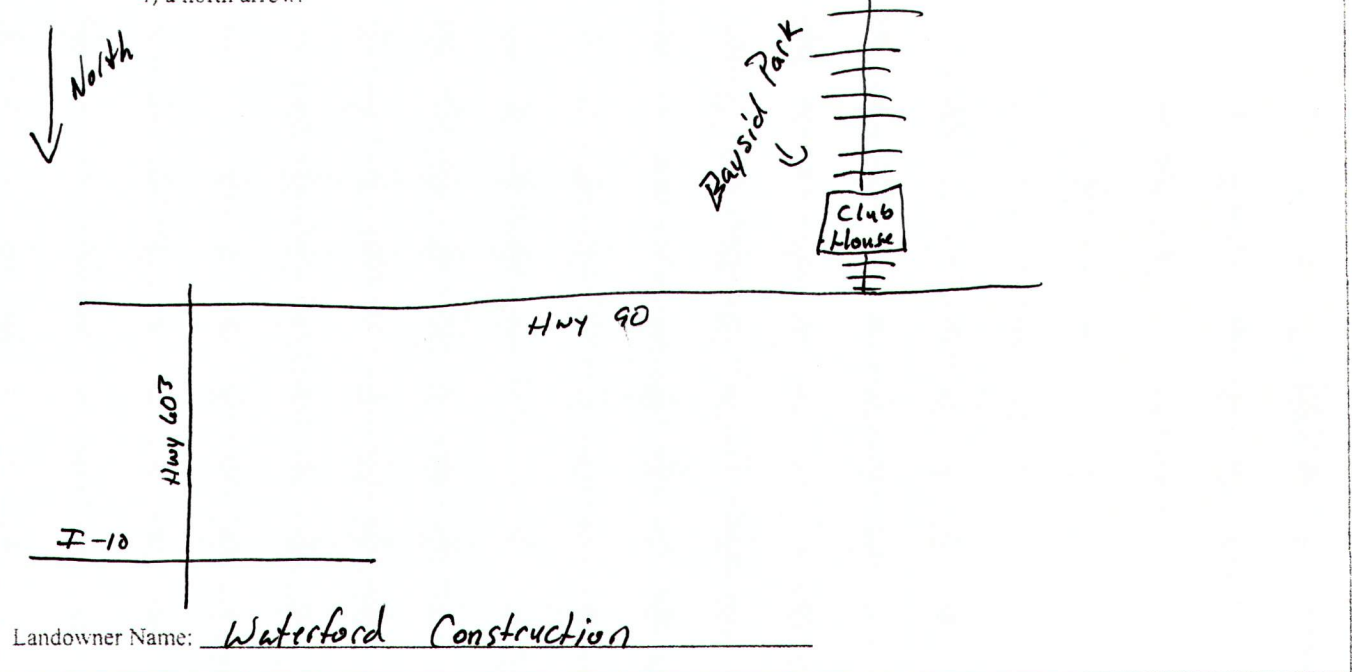

Landowner Name: Waterford Construction

I certify that the well/borehole was drilled, constructed, and completed in accordance with all applicable requirements of the Mississippi Department of Environmental Quality and the Mississippi Department of Health regulations, if applicable, and state laws.

Print Name of Responsible Licensee and License No. Malvin Wagon 0-785 Date 2-19-09 Signature of Licensee Malvin Wagon

Form: OLWR-SWR-1A  
**RECEIVED**  
 MAY 13 2009  
**BY: OLWR**

# STATE WELL REPORT

## Part 2

**Pump Installer's Completion Report**  
 Mississippi Department of Environmental Quality  
 Office of Land and Water Resources  
 P.O. Box 10631  
 Jackson, MS 39289-0631  
 (601)961-5210  
 (601)354-6938 (fax)

County: Hancock  
 Permit #: \_\_\_\_\_  
 Driller: \_\_\_\_\_  
 Date completed: 4-21-09  
*Copy information from block on Part 1*

For Office Use Only:

Aquifer: \_\_\_\_\_  
 Well #: K-884  
 Elevation: \_\_\_\_\_

*This part of the report must be completed by a licensed water well contractor or a licensed pump installer. A copy of Part 1 of the report must be attached and both parts filed with the Department at the above address within 30 days of well completion.*

Well Owner Information	Well Location
Owner Name: <u>Waterford Construction</u>	Latitude: <u>30° 16.632'</u> Longitude: <u>89° 26.628'</u>
Mailing Address: <u>7011</u>	Method of Lat/Long (check one): Conventional Survey _____
<u>W Marion</u>	USGS quad _____, Hand-held GPS _____, Survey-grade GPS _____
<u>Bay St. Louis Ms. 39520</u>	_____ 1/4 _____ 1/4 Sec _____ T _____ R _____
City State Zip Code	Distance Direction Nearest Town
Telephone No. ( ) <u>Ø</u>	_____ Miles _____ of _____

Pump Type Circle one	Power Type Circle one
Air Lift <input type="radio"/> <u>Jet</u> <input type="radio"/> Submersible	Diesel Engine <input type="radio"/> Gasoline Engine <input type="radio"/> Natural Gas <input type="radio"/>
Bucket <input type="radio"/> Piston <input type="radio"/> Turbine <input type="radio"/> <u>Electric Motor</u> <input type="radio"/> Hand <input type="radio"/> Tractor PTO <input type="radio"/>	Windmill <input type="radio"/> Other (specify): _____
Centrifugal <input type="radio"/> Rotary <input type="radio"/> Flowing Well <input type="radio"/>	Horse Power Rating of Motor: <u>1</u>
Other (specify): _____	Setting Depth: _____ feet
Date Pump Installed: _____	Number of Stages: _____
Rated Pump Capacity: _____ Gallons Per Minute	

Pump Test Data	Method of Measuring Water Level Circle one
Date Well Tested: <u>4-21-09</u>	Air Line <input type="radio"/> Electric Measuring Line <input type="radio"/> <u>Steel Tape</u> <input checked="" type="radio"/>
Static Water Level (A): <u>15</u> Feet Below Land Surface	Other (specify): _____
Pumping Water Level (B): <u>30</u> Feet Below Land Surface	For flowing well, measured shut in head: _____ feet
Drawdown [(B) - (A)]: <u>15</u> Feet Below Land Surface	Well yielded _____ GPM with a drawdown of _____
Test Pumping Rate: _____ Gallons Per Minute	_____ feet after _____ hours of pumping
Duration of Pump Test (minimum 4 hours): <u>24</u> hours	

I HEREBY CERTIFY that the above statements are true to the best of my knowledge.

ANTHONY FIVEASH JR  
 Print Name of Pump Installer and License No. (if applicable) Signature of Pump Installer

Form: OLWR-SWR-18

RECEIVED  
 MAY 13 2009  
 BY: OLWR