| County. Henceck Part 1 - Driller's Log Perma a. O - 2FC Mississippi Deparament of Environmental Quality. Date drilling conclease. Z - 2Y - 13 Mississippi Deparament of Environmental Quality. Date drilling conclease. Z - 2Y - 13 Mississippi Deparament of Environmental Quality. State Law requires that this report be prepared by the license holder responsible for the work and filed with the Department of the hold we dotters within 20 days of completion of drilling of the work and filed with the Department of the hold board of the work and filed with the Department of the hold of for a water well) Owner Name. Milling Address. 1320 Malting Address. 1320 Mississippi Deparament of Environmental Canne Order State Well Core and the work order State Mississippi Deparament. Congreticit onet: Conventional Survey. Malting Address. 1320 Nik 's Nik 's Sec. Two S. Reg. 14W Well / Borehole Data Nik 's Nik 's Sec. Two S. Reg. 14W Data drilling stated: 2-2Y Data drilling: Mississippi Deparament. Loops run circle all applicable. Nik 's Nik 's Sec. Two S. Reg. 14W Name of borehole: check one: Water Well. Cereto Contrast. Cooregized Loops in State State State. State State State. Purpose of borehole: check one: Heme Ino | | | |
|---|---|--|---|
| County Herceack Part 1 - Differ's County Audifer Permit - O - 285° Mississippi Department of Environmental Quality Audifer Differ of Land and Water Resources P.O. Box 10631 Is Elevation: No. Box 10631 Date driling complete: 2 - 28°-12 Network 1000000000000000000000000000000000000 | | State Well Report | En Offer Vis Only |
| Permit 4: | County: Hancock | | For Office Use Only: |
| Driffer: 0 - 285 ⁻ Date driffing completed: 2 - 28 - 13 Nackson, NS 39289-0631 (6011564-6938 (fax) U. S. Elevation: State Law requires that this report be prepared by the license holder responsible for the work and filed with the Department at the babove address within 30 days of completion of driffing of the work and filed with the Department at the above address within 30 days of completion of driffing of the work and filed with the Department at the above address within 30 days of completion of driffing of the work and filed with the Department at the above address within 30 days of completion of driffing of the work and filed with the Department at the above address within 30 days of completion of driffing of the work of Conventional Survey. Mailing Address Mailing Address 1320 Mailing Address of the source of any surface water used for driffing. Method of Lasol conguination running basket 2-2F Hold dasing and volume of Chorne used in driffing. Method of dasing and volume of Chorne used in driffing. Method of above dof any surface water well construction. Since Neuton Other: Name of organ | Domnit # | | |
| Jackson. MS 39289-0631 (601)351-3210 (601)354-6938 (fax) L.S. Elevation: State Law requires that this report be prepared by the license holder responsible for the work and filed with the Department at the above address within 30 days of completion of drilling of the well or borchole. E-log #: | é la companya de la c | | Well # K913 |
| Date drilling completed: 2 - 2Y-13 (6611961-5210 State Law requires that this report be prepared by the license holder responsible for the work and filled with the Department at the above address within 30 days of completent of drilling of the well or borehole. Information on Well Owner Well or Borehole is not for a water well? Owner Name_MAILILiam_Conflect Well or Borehole Excation Mailing Address 1320 Water Leave Well or Borehole is not for a water well? Owner Name_MAILILiam_Conflect 295716 Mailing Address 1320 Well of LawLong (circle one): Conventional Survey. USGS amount filled with the Distance Water Leave 295716 Data drilling started: 3-21 Date drilling completed: 3-27 Well / Borehole Data Distance Dare drilling started: 3-21 Date drilling: Well / Borehole Data Well / Borehole Data Dare drilling started: 3-21 Date drilling: Well / Borehole Location Neuron Name of organization connamic begiest 3-27 Putrose of borehole (check one): Water Well / Geotechnical/Geological Investigation_ Ground Source Heat Pump_ Seisnic Survey | | | |
| (A011354-6938 (fax) E-log #: | Date drilling completed: 3-28-13 | | E. S. Elevation: |
| Department at the above address within 39 days of completion of drilling of the well or Borchole. Information on Well Owner (Landowner if borchole is not for a water well) Owner Name_M/!!!lice_Caffer Mailing Address 1220 Dubusc_Carre Well or Borchole Location Second Address 1220 Dubusc_Carre Well of Dubusc_Carre Userstand Marting Address 1220 Dubusc_Carre Variable Data Date drilling stanted: 12-21 Date drilling stanted: 12-21 Date drilling ad evelopment: Location of the source of any surface water used for drilling: Method of dosing and volume of Chorne used in drilling and development: Logs run (circle all applicable) Variable do for downer well of corechneal/Geolegical Investigation_ Ground Source Heat Pump_ Scismic Survey | | (601)354-6938 (fax) | E-log #: |
| Information on Well Owner Well or Borchole Location Underwork if borchole is not for a water well) Owner Name_M//////////////////////////////////// | State Law requires that this repo Department at the above addres: | rt be prepared by the license holder responsible for s within 30 days of completion of drilling of the wel | the work and filed with the l or borehole. |
| Owner Name_M/III an Catter Lattude: 30: 11. Juff: Longitude: 56: 14. Juff: | Information on Well | Owner Well or B | |
| Mailing Address 1320 Mailing Address 1320 Mailing Address 1320 Weihold of Lai/Long (clicke one): Conventional Survey. USGS gued, Hind-held OPS, Survey-grade OPS Weihold of Lai/Long (clicke one): Conventional Survey. Weihold of Lai/Long (clicke one): Nearest Town Weihold of desing and volume of Chloren used in drailing and development. Location of the source of any surface water used for drilling: Method of desing and volume of Chloren used in drailing and development. Location of the source of any surface water used for drilling: Nethod of desing and volume of Chloren used in drailing and development. Location of the source of any surface water used for drilling: Name of organization running logise. Purpose of borehole theck one): Water Well: Geotechnical/Geolegical Investigation. Group of the source of Row regulation: Valve Other (describe) If a flowing well, method of flow regulation: Valve Other (describe) Static Water Level 12 feet above or blog clicke one): Neat Cement Bentonite (Mills) Veli depth: 12 well street table other: Static Water Level 12 feet Screen diameter: 11 Veli depth: 12 </td <td>(Landowner if borehole is not f</td> <td>for a water well)</td> <td>to an and and a</td> | (Landowner if borehole is not f | for a water well) | to an and and a |
| Mailing Address 1320 Mailing Address 1320 Mailing Address 1320 Weihold of Lai/Long (clicke one): Conventional Survey. USGS gued, Hind-held OPS, Survey-grade OPS Weihold of Lai/Long (clicke one): Conventional Survey. Weihold of Lai/Long (clicke one): Nearest Town Weihold of desing and volume of Chloren used in drailing and development. Location of the source of any surface water used for drilling: Method of desing and volume of Chloren used in drailing and development. Location of the source of any surface water used for drilling: Nethod of desing and volume of Chloren used in drailing and development. Location of the source of any surface water used for drilling: Name of organization running logise. Purpose of borehole theck one): Water Well: Geotechnical/Geolegical Investigation. Group of the source of Row regulation: Valve Other (describe) If a flowing well, method of flow regulation: Valve Other (describe) Static Water Level 12 feet above or blog clicke one): Neat Cement Bentonite (Mills) Veli depth: 12 well street table other: Static Water Level 12 feet Screen diameter: 11 Veli depth: 12 </td <td>Owner Name_William Cost</td> <td>Her 16 1</td> <td>Longinice: 87 17 6</td> | Owner Name_William Cost | Her 16 1 | Longinice: 87 17 6 |
| Dubuc Lane USGS auct Hami-heid GPS Invey-grade GPS Wateland Mc. 395716 City Sizte Zip Code Telephone No. 1218: 72.7 - 28.859 Well / Borehole Data Distance Direction Date drilling started: J-2.8 Date drilling completed: 3-2.9 Hole depth: 17.5 Hole diameter: 5" Location of the source of any surface water used for drilling:: Melle depth: 17.5 Hole diameter: 5" Location of the source of any surface water used for drilling:: Method of dosing and volume of Chlorine used in drilling and development: Location of the source of any surface water used for drilling:: Method of dosing and volume of Chlorine used in drilling the development: Logs run (circle all applicable) Store for organization running begiese Other (describe) If drilling is to not related to water well construction, skip the remainder of this black Purpose of borehole (check one): Hone Industrial Public Supply Intrastriation = Coher: If a flowing well, method of flow regulation: Valve Other (describe) Estime State State Water Level If a flowing well, method of a depth of If freet Type of grout (circle one): Neat Cement Bent | | Method of Lat/Long (circle o | ne): Conventional Survey, |
| Image: Concerne and the state of the st | | I'SGS augt Hand-bale | GPS. Survey-grade GPS |
| Direction Mcc. Strice City State Zip Code Telephone No. (228) 723 - 2889 Well / Borehole Data Well / Borehole Data Date drilling started: 3-28 Jate drilling started: 3-28 Date drilling completed: 3-29 Hole depth: 175 ' Location of the source of any surface water used for drilling: Method of dosing and volume of Chlorine used in drilling end development: Logs run (circle all applicable) No tog run Detter: Gamma Ray Density Sonic Neutron Other: Name of organization running log(4) Geotechnical/Geolegical Investigation Purpose of borehole (check one): Water Well Geotechnical/Geolegical Investigation Method of Measurement (check one): Home | | ane Alle NIN 2 9 | |
| Telephone No. (228: 723 - 2889 | Waveland Ma | <u>39576</u> | IWD Kng FTM |
| Well / Borchole Data Well / Borchole Data Date drilling started: 3-21 Date drilling completed: 3-21 Hole depth: 175 Hole diameter. Location of the source of any surface water used for drilling: Method of dosing and volume of Chlorine used in drilling and development: Logs run (circle all applicable) No log run Dectric Gamma Ray Density Sonie Neutron Other: Name of organization running begies: Purpose of borehole (check one): Water Well: Getotechnical/Geological Investigation | City Sta | | Nearest Town |
| Well / Borchole Data Date drilling started: 3-21 Date drilling completed: 3-21 Hole depth: 175' Hole diameter: 5'' Location of the source of any surface water used for drilling: Method of dosing and volume of Chlorine used in drilling and development: | Telephone No. (228, 323 - 2) | 8899 | of |
| Date drilling started: 3-28 Date drilling completed: 3-28 Hole depth: 175 Hole diameter: 5" Location of the source of any surface water used for drilling: Method of dosing and volume of Chlorine used in drilling and development: | | | |
| Location of the source of any surface water used for drilling: Method of dosing and volume of Chlorine used in drilling and development: Logs run (circle all applicable) So log run Dectric Gamma Ray Density Sonic Neutron Other: Name of organization running begiese Purpose of borehole (check one): Water Well Geotechnical/Geological Investigation Ground Source Heat Pump | - - - | Well / Borehole Data | |
| Location of the source of any surface water used for drilling: Method of dosing and volume of Chlorine used in drilling and development: Logs run (circle all applicable) So log run Dectric Gamma Ray Density Sonic Neutron Other: Name of organization running begiese Purpose of borehole (check one): Water Well Geotechnical/Geological Investigation Ground Source Heat Pump | Date drilling storted 7-78 Date de | 100 | <i>•</i> ′′ |
| Method of dosing and volume of Chlorine used in drilling and development: Logs run (circle all applicable) to log run Purpose of borehole (check one): Water Well Geotechnical/Geolegical Investigation Ground Source Heat Pump | , Date unning statted. | rilling completed: 5-3V Hole denth: 115 | Hole diamoter: |
| Logs run (circle all applicable) To log run Dectric Gamma Ray Density Sonic Neutron Other: Name of organization running log(sur) Purpose of borehole (check one): Water Well Geotechnical/Geological Investigation Ground Source Heat Pump | | | Hoie diameter: <u>S</u> |
| Nume of organization Funning toget: Purpose of borehole (check one): Water Well Geotechnical/Geological Investigation Ground Source Heat Pump | Location of the source of any surface wat | er used for drilling | |
| Seismic SurveyOther (describe) If drilling is not related to water well construction, skip the remainder of this block Purpose of Well (check one): Home / Industrial Public SupplyIrrigation Fish CultureOther: If a flowing well, method of flow regulation: ValveOther (describe) Static Water LevelOfeet above @ below Circle one) land surfaceDate measured: | Location of the source of any surface wat Method of dosing and volume of Chlorin | er used for drijling: | |
| Seismic SurveyOther (describe) If drilling is not related to water well construction, skip the remainder of this block Purpose of Well (check one): Home / IndustrialPublic SupplyIrrigation Fish CultureOther: | Location of the source of any surface wat Method of dosing and volume of Chlorin Logs run (circle all applicable). No log ru | er used for drilling: | |
| If drilling is not related to water well construction, skip the remainder of this block Purpose of Well (check one): Home / Industrial Public Supply Irrigation Fish Culture Other: | Location of the source of any surface wat Method of dosing and volume of Chlorin Logs run (circle all applicable). No log ru Name of organization running log(s): | ne used for drilling: | Other: |
| Purpose of Well (check one): HomeIndustrialPublic SupplyIrrigationFish CultureOther: If a flowing well, method of flow regulation: ValveOther (describe) Static Water Levelfeer above obelow circle one) land surface Date measured: Method of Measurement (circle one)electric tape air line other: Well depth:Well grouted to a depth offeerelectric tape of grout (circle one): Neat Cement Bentonite Casing length:feerinchesinches | Location of the source of any surface wat Method of dosing and volume of Chlorin Logs run (circle all applicable). No log ru Name of organization running log(s). Purpose of borehole (check one): Water W | er used for drilling: ne used in drilling and development: In Dectric Gamma Ray Density Sonic Neutron VeliGeotechnical/Geological InvestigationGround | Other: |
| If a flowing well, method of flow regulation: ValveOther (describe) | Location of the source of any surface wat Method of dosing and volume of Chlorin Logs run (circle all applicable). No log ru Name of organization running log(su Purpose of borehole (check one): Water W Seismic | ter used for drilling: | Other: d Source Heat Pump |
| If a flowing well, method of flow regulation: ValveOther (describe) | Location of the source of any surface wat Method of dosing and volume of Chlorin Logs run (circle all applicable). No log ru Name of organization running log(su Purpose of borehole (check one): Water W Seismic If drilling is not related | ter used for drilling: | Other: d Source Heat Pump |
| Static Water Level 10 feet above obelow (circle one) land surface Date measured: 3-28-17 Method of Measurement (circle one) steel tape electric tape air line other: Weli depth: 175 Well grouted to a depth of 15 feet Type of grout (circle one): Neat Cement Bentonite Mix Casing length: 165 feet Casing diameter: 2 inches Type of casing: PVC Screen length: 160 feet Screen diameter: 2 inches Type of screen: PVC Screen slot size: c006 inches Setting depth: From 165 feet feet Type of completion (circle all applicable): Gravel packed Underrearned Telescoped Open hole Natural Developmen Other (describe): | Location of the source of any surface wat Method of dosing and volume of Chlorin Logs run (circle all applicable). No log ru Name of organization running log(su Purpose of borehole (check one): Water W Seismic If drilling is not related | ter used for drilling: | Other: d Source Heat Pump |
| Method of Measurement (circle one) steel tape electric tape ait line other: Well depth: | Location of the source of any surface wat Method of dosing and volume of Chlorin Logs run (circle all applicable). No log ru Name of organization running log(su- Purpose of borehole (check one): Water W Seismic If drilling is not related Purpose of Well (check one): Home | her used for drilling: | Other: |
| Weli depth: Well grouted to a depth of Type of grout (circle one): Neat Cement Bentonite Mix Casing length: feet Casing diameter: inches Type of casing: RVC Screen length: feet Screen diameter: inches Type of screen: RVC Screen slot size: OOG inches Setting depth: From feet to feet to feet Type of completion (circle all applicable): Gravel packed Underreamed Telescoped Open hole (Natural Developmen Other (describe): | Location of the source of any surface wat Method of dosing and volume of Chlorin Logs run (circle all applicable). No log ru Name of organization running log(su- Purpose of borehole (check one): Water W Seismic If drilling is not related Purpose of Well (check one): Home | her used for drilling: | Other: |
| Casing length: | Location of the source of any surface wat Method of dosing and volume of Chlorin Logs run (circle all applicable). No log ru Name of organization running log(su- Purpose of borehole (check one): Water W Seismic If drilling is not related Purpose of Well (check one): HomeI If a flowing well, method of flow regulation Static Water Level feet all | her used for drilling: | Other: |
| Screen length: ID feet Screen diameter: Quinches Type of screen: PUC Screen slot size: | Location of the source of any surface wat Method of dosing and volume of Chlorin Logs run (circle all applicable). No log ru Name of organization running log(e). Purpose of borehole (check one): Water W Seismic <u>If drilling is not related</u> Purpose of Well (check one): Home I If a flowing well, method of flow regulation Static Water Level <u>0</u> feet all Method of Measurement (circle one) | ter used for drilling: | Other: d Source Heat Pump lock Other: |
| Screen length: 10 feet Screen diameter: 2 inches Type of screen: PIC Screen slot size: .006 inches Setting depth: From 165 feet to 175 feet Type of completion (circle all applicable): Gravel packed Underreamed Telescoped Open hole Natural Developmen Other (describe): | Location of the source of any surface wat Method of dosing and volume of Chlorin Logs run (circle all applicable). No log ru Name of organization running log(e). Purpose of borehole (check one): Water W Seismic <u>If drilling is not related</u> Purpose of Well (check one): Home I If a flowing well, method of flow regulation Static Water Level <u>0</u> feet all Method of Measurement (circle one) | ter used for drilling: | Other: d Source Heat Pump lock Other: |
| Screen slot size: | Location of the source of any surface wate Method of dosing and volume of Chlorin Logs run (circle all applicable). No log ru Name of organization running log(su Purpose of borehole (check one): Water W Seismic If drilling is not related Purpose of Well (check one): HomeI If a flowing well, method of flow regulation Static Water Level feet all Method of Measurement (circle one). Well depth: Well grouted to a dep | her used for drilling: | Other: |
| Type of completion (circle all applicable): Gravel packed Underreamed Telescoped Open hole Natural Developmen Other (describe): | Location of the source of any surface wat Method of dosing and volume of Chlorin Logs run (circle all applicable). No log ru Name of organization running log(e): Purpose of borehole (check one): Water W Seismic <u>If drilling is not related</u> Purpose of Well (check one): Home <u>I</u> If a flowing well, method of flow regulated Static Water Level <u>0</u> feet all Method of Measurement (circle one) Well depth: <u>175</u> Well grouted to a de Casing length: <u>165</u> feet Casi | ter used for drilling: | Other: |
| Other (describe): | Location of the source of any surface wat Method of dosing and volume of Chlorin Logs run (circle all applicable) no log ru Name of organization running log(e:: Purpose of borehole (check one): Water W Seismic <u>If drilling is not related</u> Purpose of Well (check one): Home <u>I</u> If a flowing well, method of flow regulated Static Water Level <u>I</u> Method of Measurement (circle one) Well depth: <u>175</u> Well grouted to a dec Casing length: <u>165</u> feet Casi Screen length: <u>165</u> feet Scree | ter used for drilling: | Other: |
| | Location of the source of any surface wat Method of dosing and volume of Chlorin Logs run (circle all applicable) No log ru Name of organization running log(e): Purpose of borehole (check one): Water W Seismic <u>If drilling is not related</u> Purpose of Well (check one): Home <u>I</u> If a flowing well, method of flow regulated Static Water Level <u>I</u> Method of Measurement (circle one) Well depth: <u>175</u> Well grouted to a def Casing length: <u>165</u> feet Casi Screen length: <u>165</u> feet Scree Screen slot size: <u>6066</u> inches | her used for drilling: | Other: |
| Top of lap pipe or reduction in casing:feet. If telescoped or more than one screen, describe on next page | Location of the source of any surface wat Method of dosing and volume of Chlorin Logs run (circle all applicable) No log ru Name of organization running log(e): Purpose of borehole (check one): Water W Seismic <u>If drilling is not related</u> Purpose of Well (check one): Home <u>I</u> If a flowing well, method of flow regulated Static Water Level <u>I</u> Method of Measurement (circle one) Well depth: <u>175</u> Well grouted to a def Casing length: <u>165</u> feet Casi Screen length: <u>165</u> feet Scree Screen slot size: <u>6066</u> inches | her used for drilling: | Other: d Source Heat Pump lock ock grad beta = 0 grad |
| | Location of the source of any surface wat Method of dosing and volume of Chlorin Logs run (circle all applicable) No log ru Name of organization running log(su Purpose of borehole (check one): Water W Seismic If drilling is not related Purpose of Well (check one): Home I If a flowing well, method of flow regulation Static Water Level I feet all Method of Measurement (circle one) Well depth: 171 Well grouted to a de Casing length: 165 feet Casi Screen length: 165 feet Scree Screen slot size: 006 inches Type of completion (circle all applicable): | her used for drilling: | Other: |

۴

.

•


· · ·

APR 2 4 2013



| The sketch below only required for water wells If well telescopes, show depths on sketch. | Description of formations encountered wells and boreholes, unless specifical | d must be provided ly exempted by reg | <u>l for all</u> rulations |
|--|---|--|-------------------------------|
| Ground Level | Description of Formations Encountered | From (depth) | To (depth) |
| | Clay | Ground Level | 15 |
| | Sand | 15- | 50 |
| | Clay | 50 | 15 |
| | Sand | 155 | 12: |
| | | | |
| | | | |
| | | - | |
| | | <u></u> | <u></u> |
| | | <u> </u> | + |
| | | | |

1

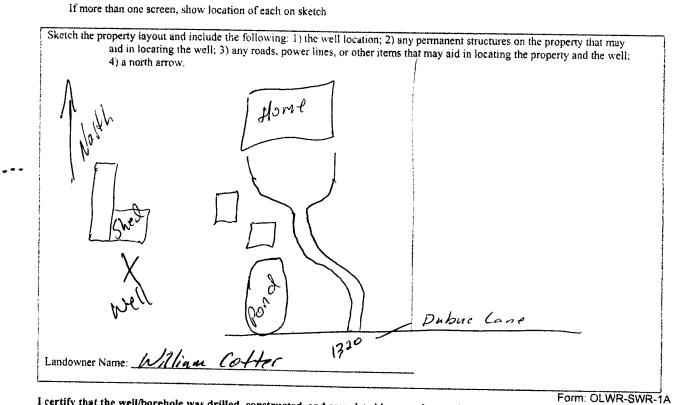

I certify that the well/borehole was drilled, constructed, and completed in accordance with all applicable requirements of the Mississippi Department of Environmental Quality and the Mississippi Department of Health regulations, if applic laws.

WAGNON MALUIN 0-785 3-28-13 Date

APR 2 4 2013

BY: OLWR

Print Name of Responsible Licensee and License No.

Signature of Licensee

| aller's Complition Report artment of Environmental Quality Land and Water Resources P.O. Box 10631 son, MS 39289-0631 (601)961-5210 01)354-6938 (fax) a detail and filed with the Department within 30 days of the Well Location Latitude: 30° 27.944 Longitude: 54° 39, 802' Method of Lat/Long (circle one): Conventional Survey, |
|---|
| Land and Water Resources P.O. Box 10631 son, MS 39289-0631 (601)961-5210 01)354-6938 (fax) a detail and filed with the Department within 30 days of the Well Location Latitude: <u>30° 27.968</u> Method of Lat/Long (circle one): Conventional Survey, |
| P.O. Box 10631 son, MS 39289-0631 (601)961-5210 01)354-6938 (fax) a detail and filed with the Department within 30 days of the Well Location Latitude: <u>30° 27.968</u> Longitude: <u>84° 39, 802</u> Method of Lat/Long (circle one): Conventional Survey, |
| son, MS 39289-0631 Well #: (601)961-5210 Elevation: 01)354-6938 (fax) Elevation: a detail and filed with the Department within 30 days of the Well Location Well Location Latitude: 30° 27.968 Longitude: 84° 39, 802' Method of Lat/Long (circle one): Conventional Survey, |
| (601)961-5210 (601)354-6938 (fax) a detail and filed with the Department within 30 days of the Well Location Latitude: <u>30° 27.968</u> Longitude: <u>84° 39,802</u> Method of Lat/Long (circle one): Conventional Survey, |
| detail and filed with the Department within 30 days of the Well Location Latitude: <u>30° 27,968</u> Longitude: <u>89° 39,802</u> Method of Lat/Long (circle one): Conventional Survey, |
| Well Location Latitude: <u>30° 27.968</u> Longitude: <u>89° 39, 802</u> Method of Lat/Long (circle one): Conventional Survey, |
| Latitude: <u>30° 27.968</u> Longitude: <u>89° 39, 802</u> Method of Lat/Long (circle one): Conventional Survey, |
| C Method of Lat/Long (circle one): Conventional Survey, |
| C Method of Lat/Long (circle one): Conventional Survey, |
| |
| USGS quad, Hand-held GPS, Survey-grade GPS |
| 6% SecTwnRng |
| |
| Distance Direction Nearest Town |
| Miles of |
| Power Type |
| Circle one |
| Diesel Engine Gasoline Engine Natural Gas |
| Rectric Motor Hand Tractor PTO |
| Windmill Other (specify): |
| Horse Power Rating of Motor: |
| Setting Depth:feet |
| Number of Stages: 2 |
| Method of Measuring Water Level |
| Circle one |
| Air Line Electric Measuring Line Steel Tape |
| Other (specify): |
| For flowing well, measured shut in head:feet |
| Well yielded GPM with a drawdown of |
| feet afterhours of pumping |
| - |

7 2

Ŋ,

ł

٠.