

Hancock

STATE WELL REPORT

County: ~~HARRISON~~
 Permit #: 0239
 Driller: McGill pump & well
 Date drilling completed: 5-25-18

Part 1
 Driller's Log
 Mississippi Department of Environmental Quality
 Office of Land and Water Resources
 P.O. Box 2309
 Jackson, MS 39225-2309
 (601)961-5555
 (601)961-5228 (fax)

For Office Use Only:
 Well #: K924
 Aquifer: _____
 E-Log #: _____

State Law requires that this report be prepared by the license holder responsible for the work and filed with the Department at the above address within 30 days of completion of drilling of the well or borehole.

Well Owner Information (Landowner if borehole is not for a water well)	Well or Borehole Location
Owner Name: John Stiglet	Latitude: 30° 19' 40.39" N Longitude: 89° 29' 32.32" W
Mailing Address: 4102 Pennsylvania Street	Method of Lat/Long (check one): Conventional Survey _____ USGS quad _____, Hand-held GPS <input checked="" type="checkbox"/> , Survey-grade GPS _____
Bay St Louis MS 39520	IR 1/4 IR 1/4, Sec. 22 40 85 R 15W
City State Zip Code	5.3 Miles North of Waveland (Distance) (Direction) (Nearest Town)
Telephone No. (228) 216-1480	

Well / Borehole Data

Date drilling started: 5-25-18 Date drilling completed: 5-25-18 Hole depth: 190 Hole diameter: 2

Location of the source of any surface water used for drilling: well water

Method of dosing and volume of Chlorine used in drilling and development: NA

Logs run (check all applicable): log run Electric Gamma Ray Density Sonic Neutron Other: NO LOG RUN

Name of organization running log(s): NA

Purpose of borehole (check one): Water Well Geotechnical/Geological Investigation Ground Source Heat Pump Seismic Survey Other (describe) _____

If drilling is not related to water well construction, skip the remainder of this block

Purpose of Well (check all applicable): Home Industrial Public Supply Irrigation Fish Culture

Other (describe): _____

If a flowing well, method of flow regulation: Valve _____ Other (describe) Back wash valve

Static Water Level: 6 feet above or below land surface Date measured: 5-25-18 (check one)

Method of measurement (check one) Steel tape Electric tape Air line Other (describe): _____

Well depth: 200 Well grouted to a depth of: 10 feet Type of grout (check one) Neat Cement Bentonite Mix

Casing length: 180 feet Casing diameter: 2 inches Type of casing: PVC

Screen length: 20 feet Screen diameter: 2 inches Type of screen: PVC

Screen slot size: .006 inches Setting depth: From 180 feet to 200 feet

Type of completion (check all applicable) gravel packed Underreamed Open hole Natural Development

Other (describe): _____

Top of lap pipe or reduction in casing: 0 feet

If telescoped or more than one screen, describe on next page

RECEIVED
 JUN 13 2018
 BY OLWR

Hancock


County: Harrison
Permit #: 0239

For Office Use Only:
Well #: K924

The sketch below only required for water wells

Description of formations encountered must be provided for all wells and boreholes, unless specifically exempted by regulations

If well telescopes, show depths on sketch.

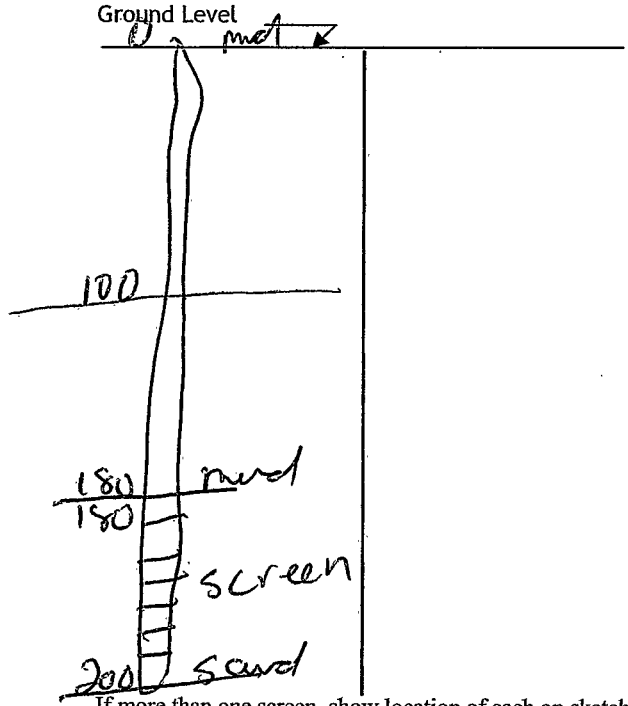

Description of Formations Encountered	From (depth) Ground level	To (depth)
mud	0	180
Sand	180	200

If more than one screen, show location of each on sketch

- Sketch the property layout and include the following:
- 1) the well location
 - 2) any permanent structures on the property that may aid in locating the well
 - 3) any roads, power lines, or other items that may aid in locating the property and the well
 - 4) north arrow

See Back
page

RECEIVED
JUN 13 2018
BY OLWR



Landowner Name: John Stiglet

I HEREBY CERTIFY that the well/borehole was drilled, constructed, and completed in accordance with all applicable requirements of the Mississippi Department of Environmental Quality and the Mississippi Department of Health regulations, if applicable, and state laws.

Michael M... #0239 6/16/18 [Signature]
Print Name of Responsible Licensee and License No. Date Signature of Licensee

Hancock Co

K924

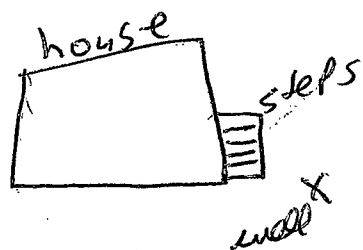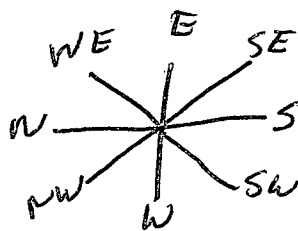

↑ ↑ ↑ trees and property line

Highway 603

Clay Drive way
4103
pennsylvania st

Arkansas st

pennsylvania st

Virginia st

Lagan st

RECEIVED
JUN 13 2018
BY OLWR