

HANCOCK

BOARD OF WATER COMMISSIONERS

K 2000

WATER WELL DRILLERS LOG

Hancock

8-26-60

Date: 8-26, 1960, Driller: Sutter Well Works County Hancock

(Name)

(1) Owner of Land: J. L. Connor  
(Name)  
Wavelands Miss.  
(Address) TOWN

(2) Location: 1/4, 1/4, Sec. 15, T. 8, R. 10  
5 miles NW, of Buy St Louis  
(distance) (direction) (Nearest Town)

(3) Topography: Flat  
(Hilly) (Flat) (Level)

(4) Purpose of Well: domestic Home  
(Domestic Irrigation  
Municipal, Industrial, Other)

Description & Color of Materials Sand, Clay, Red Clay, Shell, etc.	Thick- ness Feet	Depth Feet
Clay	15	15
sand	25	40
Clay	284	324
sand	58	382
Clay	58	440
sand	52	496
Clay	84	580
sand	71	651

Information upon completion of well:

(1) Diameter 2 inches.

(2) Total Depth 651 feet. Flow  
alone

(3) Water Level 40 feet below top of ground.

(4) Cased for 63', Size 2"


(5) Screen: Size 2", Length 20'

(6) Were any formations sealed against pollution?  
yes,  no.

If YES depth of formation \_\_\_\_\_

Why \_\_\_\_\_

Drillers Remarks: \_\_\_\_\_

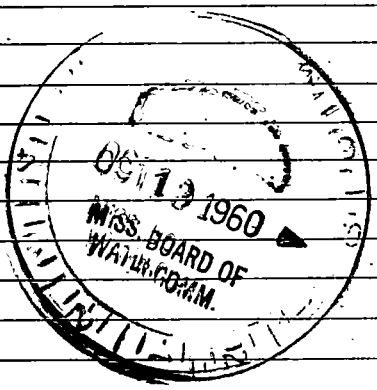

(Use Back Side)

Well No.

