

HANCOCK MISSISSIPPI BOARD OF WATER COMMISSIONERS

K 201

10-25-60

WATER WELL DRILLERS LOG

(3)

Date: 10-25, 1960, Driller: Sutton Well Works County Hancock
(Name)

(1) Owner of Land: Cecile Thomas
(Name)
Bay St. Louis, Miss.
(Address)

(2) Location: 1/4, 1/4, Sec. 26 T85 R14 W
_____ miles _____ of Bay -
(distance) (direction) (Nearest Town)

(3) Topography: flat
(Hilly) (Flat) (Level)


(4) Purpose of Well: domestic 140m
(Domestic Irrigation
Municipal, Industrial, Other)

Description & Color of Materials Sand, Clay, Red Clay, Shell, etc.	Thick- ness- Feet	Depth Feet
<u>Clay</u>	<u>10</u>	<u>10</u>
<u>sand</u>	<u>50</u>	<u>60</u>
<u>Clay</u>	<u>330</u>	<u>390</u>
<u>sand</u>	<u>60</u>	<u>450</u>
<u>Clay</u>	<u>60</u>	<u>510</u>
<u>sand</u>	<u>10</u>	<u>520</u>
<u>Clay</u>	<u>41</u>	<u>561</u>
<u>sand</u>	<u>50</u>	<u>611</u>
<u>slay</u>	<u>74</u>	<u>685</u>
<u>sand</u>	<u>50</u>	<u>735</u>

Information upon completion of well:

- (1) Diameter 2 inches.
- (2) Total Depth 743 feet.
- (3) Water Level 26 feet below top of ground. *above F 0W*
- (4) Cased to see 723, Size 2"
- (5) Screen: Size 2", Length 20
- (6) Were any formations sealed against pollution?
_____ yes, _____ no.

If YES depth of formation _____
Why _____
Drillers Remarks: th

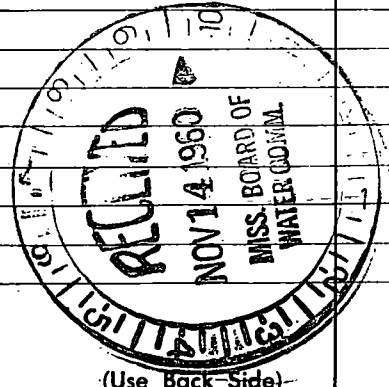

(Use Back Side)

Well No.

