

HANCOCK  
K 2004  
5-26-61

MISSISSIPPI BOARD OF WATER COMMISSIONERS

WATER WELL DRILLERS LOG

Date: 5-26, 1961, Driller: Sutter Well Works County Hancock

(Name)

(1) Owner of Land: <u>OWEN LAY</u> (Name)	Description & Color of Materials Sand, Clay, Red Clay, Shell, etc.	Thick- ness Feet	Depth Feet
<u>Box 12042 N.O. La.</u> (Address)	<u>Clay</u>	<u>10</u>	<u>10</u>
(2) Location: <u>1/4</u> , <u>1/4</u> , Sec. <u>1</u> <u>BERNARD</u>	<u>Sand</u>	<u>28</u>	<u>38</u>
<u>8</u> miles <u>NW</u> of <u>Bay St. Louis</u> (distance) (direction) (Nearest Town)	<u>Clay - sand streaks</u>	<u>83</u>	<u>121</u>
(3) Topography: <u>flat</u> (Hilly) (Flat) (Level)	<u>Sand</u>	<u>45</u>	<u>166</u>
(4) Purpose of Well: <u>domestic home</u> (Domestic Irrigation Municipal, Industrial, Other)			


Information upon completion of well:

- (1) Diameter 1 1/2 inches.
- (2) Total Depth 166 feet. Flow above
- (3) Water Level 2 feet below top of ground.
- (4) Cased to see 161, Size 1 1/2"
- (5) Screen: Size 1 1/2", Length 5'
- (6) Were any formations sealed against pollution?  
no

If YES depth of formation \_\_\_\_\_

Why \_\_\_\_\_

Drillers Remarks: \_\_\_\_\_

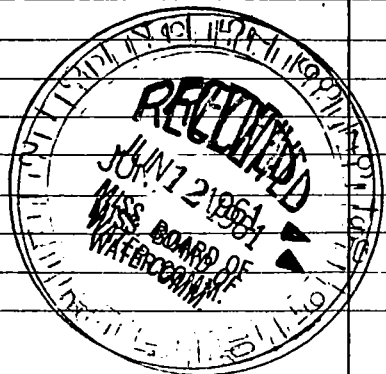

(Use Back Side)

Well No.

