

HANCOCK

MISSISSIPPI BOARD OF WATER COMMISSIONERS

K 2007

WATER WELL DRILLERS LOG

12-15-61

Date: Dec 15, 1961, Driller: J. J. Fawcett County: Hancock

(Name)

(1) Owner of Land: J. J. Deermund

(Name)

Bay St. Lewis, Shoreline Pk.

(Address)

(2) Location: 1/4, 1/4, Sec. 85 T. 14 R.

miles of (distance) (direction) (Nearest Town)

(3) Topography: Level

(Hilly) (Flat) (Level)

(4) Purpose of Well: Domestic Home

(Domestic Irrigation Municipal, Industrial, Other)

Description & Color of Materials Sand, Clay, Red Clay, Shell, etc.	Thick- ness Feet	Depth Feet
Clay was Red some pieces then Blue looking. The well plentiful sand abs to 40 ft.		

Information upon completion of well:

(1) Diameter: 4 inches.

(2) Total Depth: 155 feet.

(3) Water Level: Ground Level feet below top of ground.

(4) Cased to: None, Size: None


(5) Screen: Size: 1/4, Length: 4 ft.

(6) Were any formations sealed against pollution?
yes, no.

If YES depth of formation

Why

Drillers Remarks: Drilling went O.K.

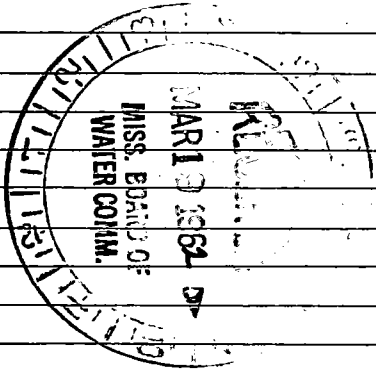

(Use Back Side)

Well No.

10

