

HANCOCK
K 2010

MISSISSIPPI BOARD OF WATER COMMISSIONERS

2-28-62

WATER WELL DRILLERS LOG

Date FEB. 28, 1962, Driller Hugo Faver County Hancock
(Name)

(1) Owner of Land: B. F. Pites
(Name)
Sherrine B. Bay St. Louis
(Address)

(2) Location: 14 9 14
1/4, 1/4, Sec. T R
4 miles W, of Bay St L
(distance) (direction) (Nearest Town)

(3) Topography: Flat
(Hilly) (Flat) (Level)

(4) Purpose of Well: Domestic
(Domestic Irrigation
Municipal, Industrial, Other)

Description & Color of Materials Sand, Clay, Red Clay, Shell, etc.	Thick- ness Foot	Depth Feet
<u>2 1/2 ft Red Clay</u>		<u>12 1/2</u>
<u>1 1/2 ft</u>		
<u>Sand White</u>		<u>20 1/2</u>
<u>Then Blue Clay</u>		
<u>& Shells.</u>		

Information upon completion of well:

(1) Diameter 12 1/2 inches.

(2) Total Depth 157 feet.

(3) Water Level _____ feet below top of ground.

(4) Cased to 147, Size None


(5) Screen: Size 2 in., Length 16 ft.

(6) Were any formations sealed against pollution?
✓ yes, no.

If YES depth of formation _____

Why _____

Drillers Remarks: No trouble
Well Completed in
2 days.

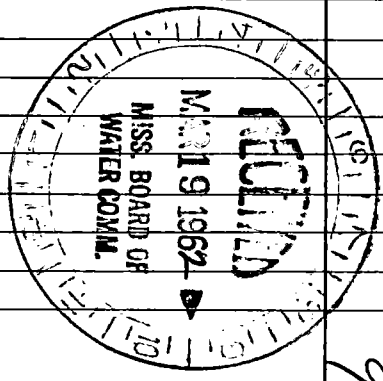

(Use Back Side)

Well No. 9

