

HANCOCK

MISSISSIPPI BOARD OF WATER COMMISSIONERS

K 2011

3-2-62

WATER WELL DRILLERS LOG

Date: Mar. 2, 1962, Driller: Hugh Farrow County Hancock
(Name)

(1) Owner of Land: <u>James Finnan</u> (Name)	Description & Color of Materials Sand, Clay, Red Clay, Shell, etc.	Thick- ness Feet	Depth Feet
<u>New Orleans, La.</u> (Address)	<u>Red Clay</u>		
(2) Location: <u>5 9 14 W</u> 1/4, 1/4, Sec. T R	<u>Shells & Sand</u>		
<u>5</u> miles <u>W.</u> of <u>Bay St Louis</u> (distance) (direction) (Nearest Town)			
(3) Topography: <u>Level</u> (Hilly) (Flat) (Level)			
(4) Purpose of Well: <u>Domestic Home</u> (Domestic Irrigation Municipal, Industrial, Other)			


Information upon completion of well:

- (1) Diameter 2 inches.
- (2) Total Depth 140 feet.
- (3) Water Level _____ feet below top of ground.
- (4) Cased to None¹³⁰, Size None.
- (5) Screen: Size 2 in., Length 10 ft.
- (6) Were any formations sealed against pollution?
 yes, no.

If YES depth of formation _____

Why _____

Drillers Remarks: No Trouble.

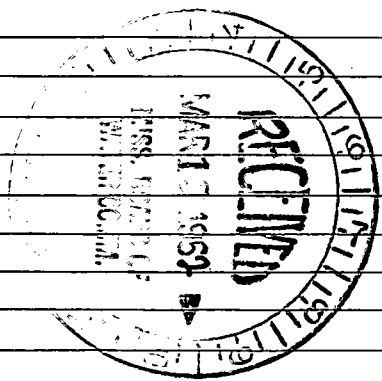

10

Well No.

(Use Back Side)

