

HANCOCK

MISSISSIPPI BOARD OF WATER COMMISSIONERS

K 2012

3-20-62

WATER WELL DRILLERS LOG

Date: Mar 20, 1962 Driller: Hugo Farrow County: Hancock
(Name)

(1) Owner of Land: M. Waller
(Name)

Washington Rd.
(Address)

(2) Location: 34 8s 14e
_____ $\frac{1}{4}$, _____ $\frac{1}{4}$, Sec. _____ T _____ R _____

1 miles W Bryant Lewis
(distance) (direction) (Nearest Town)

(3) Topography: Level
(Hilly) (Flat) (Level)

(4) Purpose of Well: Domestic Home
(Domestic Irrigation
Municipal, Industrial, Other)

Description & Color of Materials
Sand, Clay, Red Clay, Shell, etc.

Thick-
ness
Feet

Depth
Feet

Information upon completion of well:

(1) Diameter 2 inches.

(2) Total Depth 140 feet.

(3) Water Level 3 feet below top of ground.

(4) Cased to None ¹³⁰, Size None

(5) Screen: Size 2 in, Length 10 ft.


(6) Were any formations sealed against pollution?

____ yes, no.

If YES depth of formation _____

Why _____

Drillers Remarks: _____

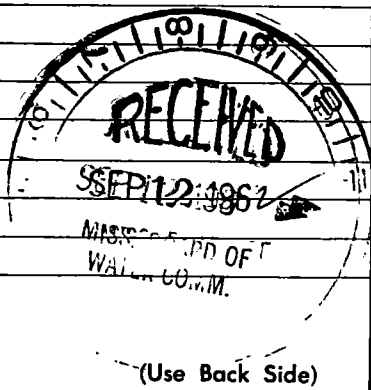

(Use Back Side)

Well No. _____

