

2015

7-62

WATER WELL DRILLERS LOG

Date: July, 1962, Driller: Edwyn Farrow County Hancock (Name)


(1) Owner of Land: Mrs Mrs John A. Sciana (Name)	Description & Color of Materials Sand, Clay, Red Clay, Shell, etc.	Thick- ness Feet	Depth Feet
305 SECOND STREET BAY ST Louis miss (Address)			
(2) Location: 1/4, 1/4, Sec 24 T 8 R 4 miles, of B.S.L. (distance) (direction) (Nearest Town)			
(3) Topography: Flat (Hilly) (Flat) (Level)			
(4) Purpose of Well: Irrigation (Domestic Irrigation Municipal, Industrial, Other)			

Information upon completion of well:

- (1) Diameter 2 inches.
- (2) Total Depth 127 feet.
- (3) Water level 10 ft feet below top of ground.
- (4) Cased to 147, Size -
- (5) Screen: Size 2 in, Length 10 ft.
- (6) Were any formations sealed against pollution?
yes, no.

If YES depth of formation _____
Why _____

Drillers Remarks: _____

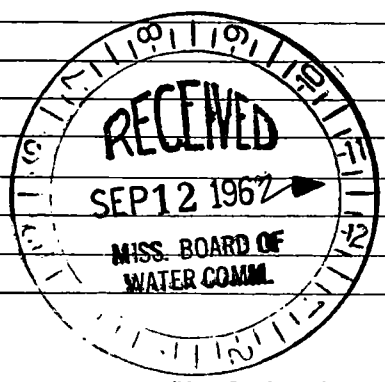

21

Well No.

