

K 2017

WATER WELL DRILLERS LOG

K

8-31-62

Date: 8-31, 1962, Driller: Sutter Well Works County Hancock

(Name)

(1) Owner of Land: J. Z. Schwenn  
 (Name)  
246 Sharon Dr. N.O. La.  
 (Address)

(2) Location: NE 1/4, NE 1/4, Sec. 13 T. 85 R. 14 W  
6 miles NW of Bay St Louis  
 (distance) (direction) (Nearest Town)

(3) Topography: Flat  
 (Hilly) (Flat) (Level)

(4) Purpose of Well: domestic Home  
 (Domestic Irrigation  
 Municipal, Industrial, Other)

Description & Color of Materials Sand, Clay, Red Clay, Shell, etc.	Thick- ness Feet	Depth Feet
Clay	20	20
Sand	15	35
Clay	26	61
Sand	31	92
Clay	73	165
Sand streaks	85	250
Sand	46	296

Information upon completion of well:

(1) Diameter 2 inches.

(2) Total Depth 296 feet.

(3) Water Level 1 feet above FLOW below top of ground.

(4) Cased to all 291, Size 2".


(5) Screen: Size 2", Length 5'.

(6) Were any formations sealed against pollution?  
 \_\_\_\_\_ yes,  no.

If YES depth of formation \_\_\_\_\_

Why \_\_\_\_\_

Drillers Remarks: \_\_\_\_\_

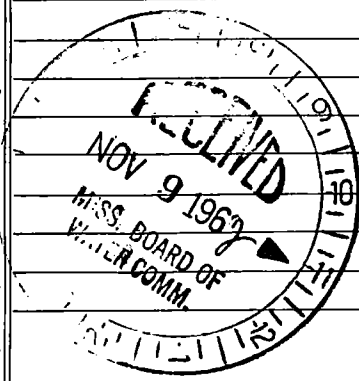

(Use Back Side)

Well No.

Handwritten text at the top of the page, possibly a title or header.

Vertical handwritten text on the left side of the page.

Vertical handwritten text in the middle-left section.

Main body of handwritten text in the upper right quadrant.

Handwritten text in the lower right quadrant, including some numbers and symbols.