

K 2019

10-15-62

WATER WELL DRILLERS LOG

K

Date: 10-15, 1962, Driller: Autter Well Works County Hancock

(Name)


(1) Owner of Land: J.C. Kinbead
(Name)
Bay St. Louis, Miss.
(Address)
15
 (2) Location: SE 1/4, SW 1/4, Sec. 46 T85R14W
2 miles NW, of Bay St. Louis
(distance) (direction) (Nearest Town)
 (3) Topography: flat
(Hilly) (Flat) (Level)
 (4) Purpose of Well: domestic home
(Domestic Irrigation Municipal, Industrial, Other)

Description & Color of Materials Sand, Clay, Red Clay, Shell, etc.	Thick- ness Feet	Depth Feet
clay	12	12
sand	18	30
clay	50	80
sand	15	95
clay	35	130
sand	22	152

Information upon completion of well:

(1) Diameter 1 1/4 inches.
 (2) Total Depth 152 feet. Flow
 (3) Water Level 1/2 feet above below top of ground.
 (4) Cased to top, Size 1 1/4"
 (5) Screen: Size 1 1/4", Length 5'
 (6) Were any formations sealed against pollution?
 _____ yes, no.

If YES depth of formation _____
 Why _____
 Drillers Remarks: _____

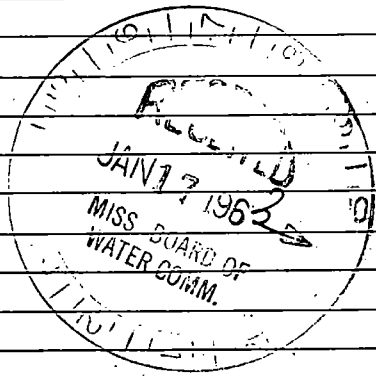

(Use Back Side)

Well No.

Account of the ...

1811
1812
1813
1814
1815
1816
1817

...

...

...