

K 7070

WATER WELL DRILLERS LOG

K

10-25-62

Date: 10-25, 1962, Driller: Sutter Well Works County Hancock

(Name)

(1) Owner of Land: John Sciana (Name) 305-2nd St Bay St Louis Miss (Address)

Description & Color of Materials Sand, Clay, Red Clay, Shell, etc.	Thick- ness Feet	Depth Feet
Surface clay	18	18
sand	160	178

(2) Location: SE 1/4, SE 1/4, Sec. 26 T8S R14 W 1 miles NW of Bay St Louis (distance) (direction) (Nearest Town)

upper fine - lower 26' coarse

(3) Topography: flat (Hilly) (Flat) (Level)

(4) Purpose of Well: domestic home (Domestic Irrigation Municipal, Industrial, Other)


Information upon completion of well:

- (1) Diameter 2 inches.
- (2) Total Depth 178 feet.
- (3) Water Level 17 feet below top of ground.
- (4) Cased to 168, Size 2"
- (5) Screen: Size 2", Length 10'
- (6) Were any formations sealed against pollution? yes,  no.

If YES depth of formation

Why

Drillers Remarks:

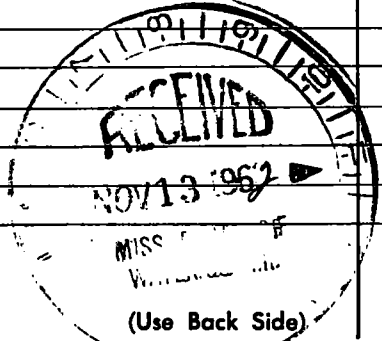

Well No.

