

K 2021

WATER WELL DRILLERS LOG

K

10-30-62

Date: 10-30, 1962, Driller: Sutter Well Works County Hancock
(Name)

| | Description & Color of Materials Sand, Clay, Red Clay, Shell, etc. | Thick- ness Feet | Depth Feet |
|--|---|------------------------|---------------|
| (1) Owner of Land: <u>Mrs. Fried</u> (Name) | Clay | 12 | 12 |
| <u>73200 Wayne Blvd. New Orleans</u> (Address) | Sand | 73 | 85 |
| (2) Location: <u>NE 1/4, NW 1/4, Sec. 40 T85R 14W</u> | Clay | 85 | 170 |
| <u>5</u> miles <u>NW</u> of <u>Bay St Louis</u> (distance) (direction) (Nearest Town) | Sand | 35 | 205 |
| (3) Topography: <u>flat</u> (Hilly) (Flat) (Level) | <u>(well set at 189 feet)</u> | | |
| (4) Purpose of Well: <u>domestic home</u> (Domestic Irrigation Municipal, Industrial, Other) | | | |


Information upon completion of well:

- (1) Diameter 1 1/2 inches.
- (2) Total Depth 189 feet.
- (3) Water Level 1 feet below top of ground.
- (4) Cased to 179 feet, Size 1 1/4"
- (5) Screen: Size 2", Length 10'
- (6) Were any formations sealed against pollution?
yes, no.

If YES depth of formation _____


Why _____

Drillers Remarks: _____

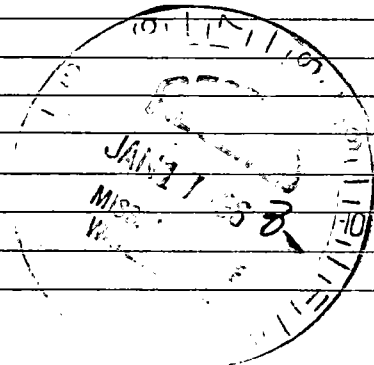

(Use Back Side)

Well No.

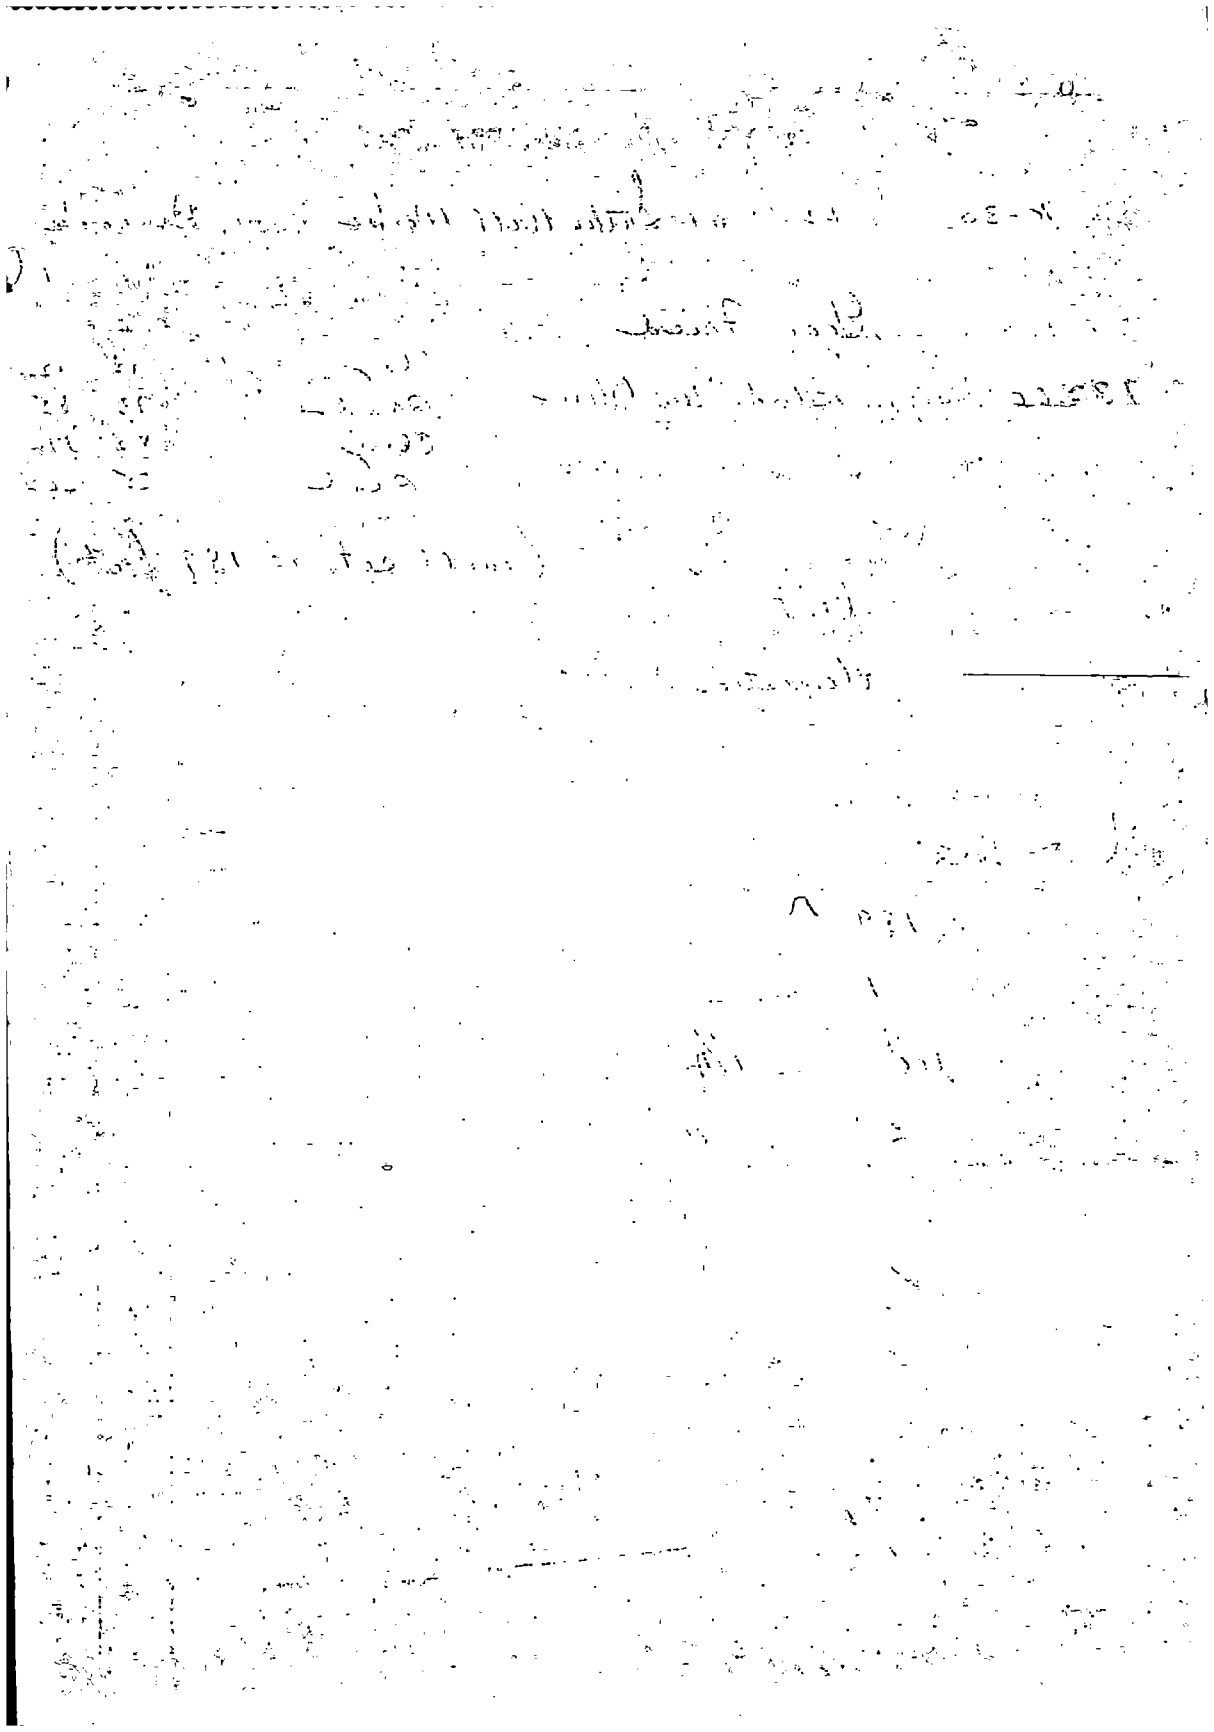

1982-1983

Final Report

1982-1983

(1982-1983)

1982

1

1981

1982

2

3

4

5