

K 2023

WATER WELL DRILLERS LOG

K

11-14-62

Date: 11-14, 1962, Driller: Lutter Well Works County Hancock

Contracted for by Schwall (Name)

(1) Owner of Land: Carmichael (Name)

(Address) 27

(2) Location NE 1/4, NE 1/4, Sec. 28 T. 85 R. 14 W

3 miles NW of Bay St Louis (distance) (direction) (Nearest Town)

(3) Topography: flat (Hilly) (Flat) (Level)

(4) Purpose of Well: domestic Home (Domestic Irrigation Municipal, Industrial, Other)

Information upon completion of well:

- (1) Diameter 1 1/4 inches.
(2) Total Depth 158 feet.
(3) Water Level 1/2 feet above Flow below top of ground.
(4) Cased to 200, Size 1 1/4"
(5) Screen: Size 1 1/4", Length 5'
(6) Were any formations sealed against pollution?
yes, no.

If YES depth of formation

Why


Drillers Remarks:

Description & Color of Materials Sand, Clay, Red Clay, Shell, etc.

Thick-ness Feet

Depth Feet

Table with 3 columns: Description & Color of Materials, Thickness Feet, Depth Feet. Rows include Surface, sand, clay, sand with corresponding measurements.

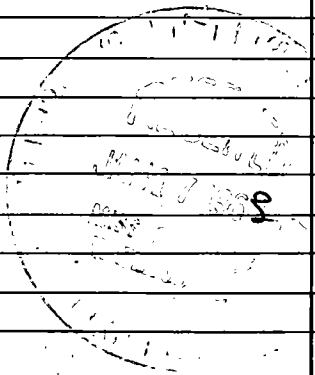

(Use Back Side)

Well No.

