

HANCOCK MISSISSIPPI BOARD OF WATER COMMISSIONERS

K 2098

3-8-63

WATER WELL DRILLERS LOG

K

Date: 3-8, 1963, Driller: Butter Well Works County Hancock

(Name)


(1) Owner of Land:	Description & Color of Materials Sand, Clay, Red Clay, Shell, etc.	Thick-ness Feet	Depth Feet
<i>Cornelius Ladner</i> (Name)			
<i>Bay St Louis</i> (Address) <i>SUB DIV</i>	<i>Clay</i>	<i>15</i>	<i>15</i>
	<i>sand</i>	<i>74</i>	<i>89</i>
(2) Location: $\frac{1}{4}$, $\frac{1}{4}$, Sec. <i>T88 N42 W</i>			
<i>10</i> miles (distance) <i>in</i> (direction), of <i>Bay St Louis</i> (Nearest Town)			
(3) Topography: <i>flat</i> (Hilly) (Flat) (Level)			
(4) Purpose of Well: <i>Air Conditioning</i> (Domestic Irrigation) (Municipal, Industrial, Other)			

Information upon completion of well:

- Diameter 2 inches.
- Total Depth 89 feet.
- Water Level 14 feet below top of ground.
- Cased to alt, Size 2"
- Screen: Size 2", Length 5'
- Were any formations sealed against pollution?
 yes, no.

If YES depth of formation _____
Why _____

Drillers Remarks: _____

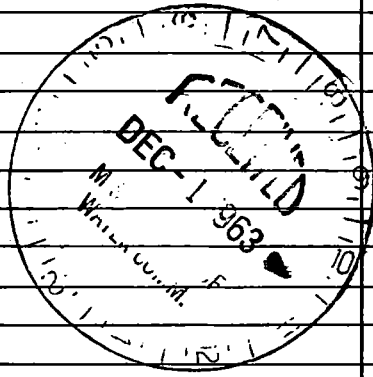

(Use Back Side)

Well No.

10

10/10/10

10/10/10

10

10

