

K 2029
3-25-63

WATER WELL DRILLERS LOG

K

Date: 3-25, 1963, Driller: Sutter Well Works County Hancock
(Name)

(1) Owner of Land: ROBT. ABRAMSON
(Name)
4409 DREUX AVE. N.D. LA.
(Address)

(2) Location: NE 1/4, SW 1/4, Sec. 40 T8S R14W
8 miles NW of Bay St Louis
(distance) (direction) (Nearest Town)

(3) Topography: flat
(Hilly) (flat) (Level)

(4) Purpose of Well: domestic Home
(Domestic Irrigation, Municipal, Industrial, Other)

Description & Color of Materials Sand, Clay, Red Clay, Shell, etc.	Thick- ness Foot	Depth Foot
<u>soft clay - sand streaks</u>	<u>94</u>	<u>94</u>
<u>sand & gravel</u>	<u>10</u>	<u>104</u>
<u>fine sand & mud</u>	<u>68</u>	<u>172</u>
<u>sand</u>	<u>18</u>	<u>190</u>

Information upon completion of well:

(1) Diameter 2 inches.


(2) Total Depth 190 feet.

(3) Water Level 1 feet below top of ground.

(4) Cased to 185, Size 2"

(5) Screen: Size 2", Length 5'

(6) Were any formations sealed against pollution?
no

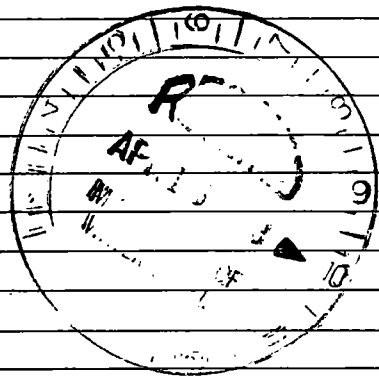

If YES depth of forgnation _____

Why _____

Drillers Remarks: _____

(Use Back Side)

Well No.

1. 1944

2. 1945

3.

4.

5. 1946

6. 1947

7. 1948

43. 1984