

K 2030
3-30-63

WATER WELL DRILLERS LOG

K

Date: 3-30, 1963, Driller: Suttler Well Works County Hancock

(Name)

(1) Owner of Land: W. H. Barnes
(Name)

Bay St. Louis Miss.
(Address)

(2) Location: SW 1/4, SW 1/4, Sec. 17 T85R 14W

8 miles NW of Bay St. Louis
(distance) (direction) (Nearest Town)

(3) Topography: flat
(Hilly) (Flat) (Level)

(4) Purpose of Well: domestic home
(Domestic Irrigation
Municipal, Industrial, Other)

Description & Color of Materials Sand, Clay, Red Clay, Shell, etc.	Thick-ness Feet	Depth Feet
Sand	30	30
Cherty clay	65	95
sand	40	135

Information upon completion of well:

(1) Diameter 2 inches.

(2) Total Depth 135 feet.

(3) Water Level 3 feet below top of ground.

(4) Cased to 130, Size 2"

(5) Screen: Size 2", Length 5'


(6) Were any formations sealed against pollution?

yes, no.

If YES depth of formation _____

Why _____

Drillers Remarks: _____

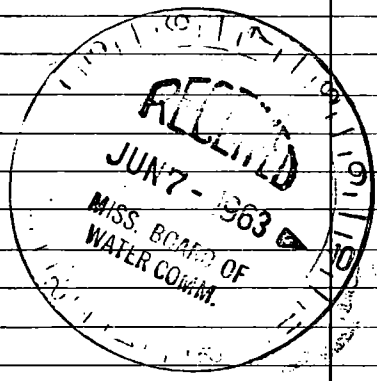

(Use Back Side)

Well No. _____

