

HANCOCK

MISSISSIPPI BOARD OF WATER COMMISSIONERS

K 2031

3-30-63

WATER WELL DRILLERS LOG

K

Date: 3-30, 1963, Driller: Sutter Well Works County 7. Lincoln

(Name)

(1) Owner of Land: M J Hallman (Name)

Bay St. Louis, Miss. (Address)

(2) Location: SW 1/4, SW 1/4, Sec. 17 T85R 14W

8 miles NW of Bay St. Louis (distance) (direction) (Nearest Town)

(3) Topography: flat (Hilly) (Flat) (Level)

(4) Purpose of Well: Domestic Home (Domestic Irrigation Municipal, Industrial, Other)

Description & Color of Materials Sand, Clay, Red Clay, Shell, etc.	Thick- ness Feet	Depth Feet
Clay	15	15
sand	56	71
Clay	50	121
sand	14	135
Clay	19	154
sand	25	179

Information upon completion of well:

(1) Diameter 2 inches.

(2) Total Depth 135 feet.

(3) Water Level 1 foot above flood ground. 130

(4) Cased to 2" Size

(5) Screen: Size 2", Length 5'


(6) Were any formations sealed against pollution?

yes, no. [checked]

If YES depth of formation

Why

Drillers Remarks:

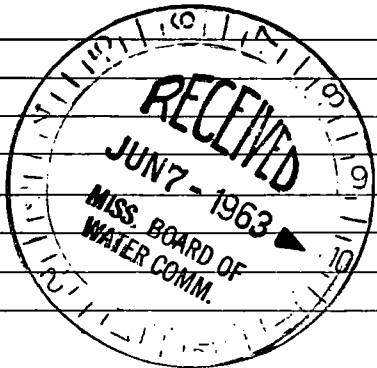

(Use Back Side)

Well No.

Handwritten text at the top of the page, possibly a title or header, which is mostly illegible due to the high contrast and noise of the scan.

Main body of handwritten text, consisting of several lines of cursive script. The text is extremely faint and difficult to decipher, but appears to be a continuous paragraph or list of entries. The lines are roughly horizontal and follow the general flow of the page.