

HANCOCK MISSISSIPPI BOARD OF WATER COMMISSIONERS

K. 2032

4-20-63

WATER WELL DRILLERS LOG

K

Date: 4-20, 1963, Driller: Sutton Well Works County Hancock

(Name)

(1) Owner of Land: WP Basworth
 (Name)
Bay St. Louis
 (Address)

Description & Color of Materials
 Sand, Clay, Red Clay, Shell, etc.

Thick-
ness
Feet

Depth
Feet

Clay	12	12
Sand	43	55
Clay	10	65
Sand	45	110

(2) Location: 1/4, 1/4, Sec. T8R14W
1 miles IN Bay St. Louis
 (distance) (direction) (Nearest Town)

(3) Topography: Flat
 (Hilly) (Flat) (Level)

(4) Purpose of Well: irrigation
 (Domestic Irrigation
 Municipal, Industrial, Other)

Information upon completion of well:

(1) Diameter 4 inches.

(2) Total Depth 110 feet.

(3) Water Level 19 feet below top of ground.

(4) Cased to 100, Size 4"


(5) Screen: Size 4", Length 10'

(6) Were any formations sealed against pollution?
no

If YES depth of formation _____

Why _____

Drillers Remarks: _____

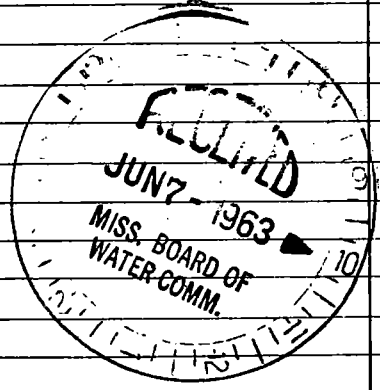

(Use Back Side)

Well No.

