

K 2034

5-6-63

WATER WELL DRILLERS LOG

K

Date: May 6, 1963, Driller: M & B Drilling Co. County Hancock

(Name)

(1) Owner of Land: Coleman Lindsey  
(Name)  
608 Shadow Peak Bay St. Louis  
(Address)

(2) Location: 1/4, 1/4, Sec. 27 T 88 R 14  
3 miles NW, of Bay St. Louis  
(distance) (direction) (Nearest Town)

(3) Topography: Flat  
(Hilly) (Flat) (Level)

(4) Purpose of Well: Domestic Home  
(Domestic Irrigation Municipal, Industrial, Other)

Information upon completion of well:

(1) Diameter 2 inches.

(2) Total Depth 322 feet.

(3) Water Level Flowing feet below top of ground.

(4) Cased to 2 1/8 31, Size 2"

(5) Screen: Size 2" x 1/8", Length 5 FT


(6) Were any formations sealed against pollution?  
 \_\_\_\_\_ yes, \_\_\_\_\_ no.

If YES depth of formation \_\_\_\_\_

Why \_\_\_\_\_

Drillers Remarks: \_\_\_\_\_

Description & Color of Materials Sand, Clay, Red Clay, Shell, etc.	Thick- ness Feet	Depth Feet
<del>Clay</del>		
Top Soil	6	6
Yellow Sand	6	12
Blonde Sand	11	23
White Sand	11	34
Blue Clay	10	44
Blue Clay & Clamshell	11	55
Blue Clay	10	65
Clamshell & Blue Clay	8	73
Sand	8	81
Blue Clay	3	84
Sand	26	110
Blue Clay	5	115
White Sand	9	124
Blue Clay	2	126
Grey Sand	9	135
Blue Clay	23	158
Fine Grey Sand	16	174
Blue Clay	34	208
Limestone	3	211
Fine Sand	5	216
Blue Clay	6	222
Limestone	2	224
Blue Clay	64	288
Grey Sand	40	330

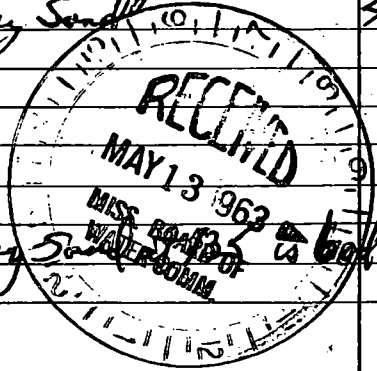

Grey Sand 5' to 10' water

(Use Back Side)

Well No.

*[The page contains extremely faint and illegible handwritten text, likely bleed-through from the reverse side. The text is scattered across the page and is difficult to decipher.]*