

HANCOCK
K 2035

MISSISSIPPI BOARD OF WATER COMMISSIONERS

WATER WELL DRILLERS LOG

K

5-17-63

Date: 5-17, 1963, Driller: Sutter Well Works County Hancock
(Name)

(1) Owner of Land: LELAND DAVID
(Name)
832 ST. PHILIP ST. N. O. LA.
(Address)

(2) Location: SW 1/4, SW 1/4, Sec. 17 T85R14W
8 miles NW, of Bay St. Louis
(distance) (direction) (Nearest Town)

(3) Topography: flat
(Hilly) (Flat) (Level)

(4) Purpose of Well: domestic home
(Domestic Irrigation
Municipal, Industrial, Other)

Description & Color of Materials Sand, Clay, Red Clay, Shell, etc.	Thick- ness Feet	Depth Feet
<u>Clay</u>	<u>15</u>	<u>15</u>
<u>sand</u>	<u>54</u>	<u>69</u>
<u>Clay</u>	<u>77</u>	<u>146</u>
<u>sand</u>	<u>14</u>	<u>160</u>


Information upon completion of well:

- (1) Diameter 2 inches.
- (2) Total Depth 160 feet. Flow
- (3) Water Level 1 above feet below top of ground. 155
- (4) Cased to app, Size 2"
- (5) Screen: Size 2", Length 5'
- (6) Were any formations sealed against pollution?
 yes, no.

If YES depth of formation _____

Why _____

Drillers Remarks: _____

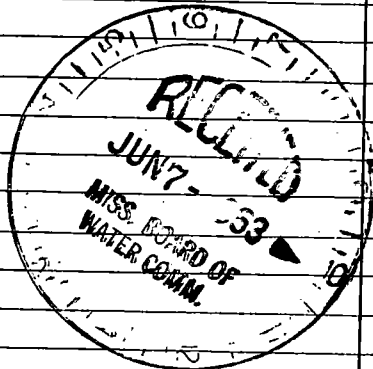

(Use Back Side)

Well No.

