

HANCOCK

MISSISSIPPI BOARD OF WATER COMMISSIONERS

K 2038

WATER WELL DRILLERS LOG

K

6-5-63

Date: 6-5, 1963, Driller: Jutter Well Works County Hancock

(Name)

(1) Owner of Land: Annette Myers

(Name)

Bay St. Louis Miss.

(Address) / 27

(2) Location: NE 1/4, NE 1/4, Sec. 46 T. 55R14W

2 miles NW, of Bay St. Louis

(distance) (direction) (Nearest Town)

(3) Topography: flat

(Hilly) (Flat) (Level)

(4) Purpose of Well: domestic Home

(Domestic Irrigation Municipal, Industrial, Other)

Information upon completion of well:

(1) Diameter: 2 inches.

(2) Total Depth: 152 feet.

(3) Water level: 147 feet below top of ground.

(4) Cased to: 2", Size: 2"

(5) Screen: Size: 2, Length: 5'

(6) Were any formations sealed against pollution?

yes, [checked] no.

If YES depth of formation

Why

Drillers Remarks:

Description & Color of Materials Sand, Clay, Red Clay, Shell, etc.

Thick-ness Feet

Depth Feet

Sand

30 30

Clay

25 55

Sand


23 78

Clay

55 133

Sand

19 152

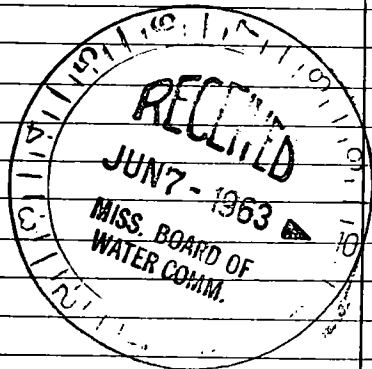

Well No.

(Use Back Side)

