

K 2039  
6-5-63

WATER WELL DRILLERS LOG

K

Date: 6-5, 1963, Driller: Sutter Well Works County Hancock  
(Name)

(1) Owner of Land: Chas Fisher  
(Name)  
Bay St Louis, Miss.  
(Address)

(2) Location: SW 1/4, NE 1/4, Sec. 46 T85R14W  
1 miles W, of Bay St Louis  
(distance) (direction) (Nearest Town)

(3) Topography: flat  
(Hilly) (Flat) (Level)

(4) Purpose of Well: Domestic Home  
(Domestic Irrigation  
Municipal, Industrial, Other)

Description & Color of Materials Sand, Clay, Red Clay, Shell, etc.	Thick- ness Feet	Depth Feet
<u>Sand</u>	<u>30</u>	<u>30</u>
<u>Clay</u>	<u>102</u>	<u>132</u>
<u>Sand</u>	<u>20</u>	<u>152</u>

Information upon completion of well:

(1) Diameter 2 inches.

(2) Total Depth 152 feet. Flow

(3) Water Level 1 feet above below top of ground.

(4) Cased to 147, Size 2"


(5) Screen: Size 2", Length 5'

(6) Were any formations sealed against pollution?  
no yes,  no.

If YES depth of formation \_\_\_\_\_

Why \_\_\_\_\_

Drillers Remarks: \_\_\_\_\_

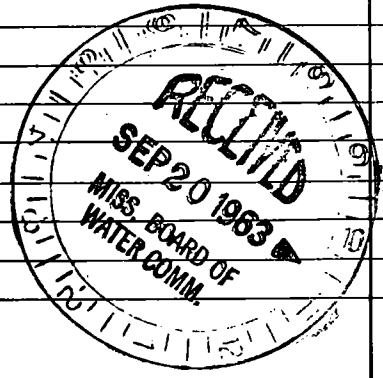

(Use Back Side)

Well No.

Journal of the [illegible] [illegible] [illegible]

[The remainder of the page contains extremely faint and illegible text, likely bleed-through from the reverse side of the document.]