

K 2041
7-18-63

WATER WELL DRILLERS LOG

K

Date: 7-18, 1963, Driller: Sutter Well Works County Hancock
(Name)

(1) Owner of Land: H. H. Frenzel
131 Nursery Avenue
Metairie, Louisiana
(Name)
(Address)

(2) Location: SE $\frac{1}{4}$, NW $\frac{1}{4}$, Sec. 40 T8S R14W
5 miles W of Bay St Louis
(distance) (direction) (Nearest Town)

(3) Topography: flat
(Hilly) (Flat) (Level)

(4) Purpose of Well: domestic Home
(Domestic Irrigation
Municipal, Industrial, Other)

Description & Color of Materials Sand, Clay, Red Clay, Shell, etc.	Thick- ness Feet	Depth Feet
Clay	10	10
Sand	32	42
Clay	48	90
sand - clay streaks	25	115
sand	15	130
Clay	20	150
sand	18	168

Information upon completion of well:

(1) Diameter 2 inches.

(2) Total Depth 168 feet.

(3) Water Level 1 feet below top of ground.

(4) Cased to 163, Size 2"


(5) Screen: Size 2", Length 5'

(6) Were any formations sealed against pollution?
yes, no.

If YES depth of formation _____

Why _____

Drillers Remarks: _____

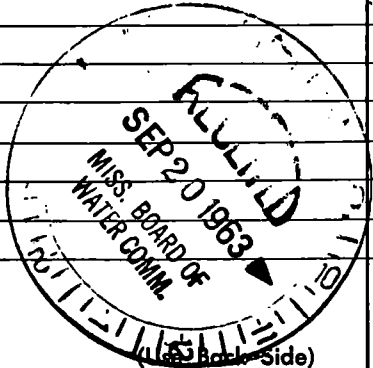

Well No.

Account

Account

21

1891	100	100	100	100	100	100	100	100	100
1892	100	100	100	100	100	100	100	100	100
1893	100	100	100	100	100	100	100	100	100
1894	100	100	100	100	100	100	100	100	100
1895	100	100	100	100	100	100	100	100	100
1896	100	100	100	100	100	100	100	100	100
1897	100	100	100	100	100	100	100	100	100
1898	100	100	100	100	100	100	100	100	100
1899	100	100	100	100	100	100	100	100	100
1900	100	100	100	100	100	100	100	100	100

1891

Faint, illegible text covering the lower half of the page, possibly representing a list or detailed account entries.