

K 2042  
8-13-63

WATER WELL DRILLERS LOG

K

Date: 8-13, 1963, Driller: Sutter Well Works County Hancock  
(Name)

(1) Owner of Land: Frank Langenbacher  
(Name)  
Rt 2 Bay St Louis, Miss.  
(Address)

(2) Location: SW 1/4, NE 1/4, Sec. 34 T85R14W  
2 miles W of Bay St Louis  
(distance) (direction) (Nearest Town)

(3) Topography: flat  
(Hilly) (Flat) (Level)

(4) Purpose of Well: domestic home  
(Domestic Irrigation  
Municipal, Industrial, Other)

Description & Color of Materials Sand, Clay, Red Clay, Shell, etc.	Thick- ness Feet	Depth Feet
<u>Sand</u>	<u>80</u>	<u>80</u>
<u>Clay</u>	<u>23</u>	<u>103</u>
<u>Sand</u>	<u>35</u>	<u>138</u>
<u>Clay</u>	<u>105</u>	<u>243</u>
<u>Sand</u>	<u>30</u>	<u>273</u>

Information upon completion of well:

(1) Diameter 2 inches.

(2) Total Depth 273 feet.

(3) Water Level 14 feet below top of ground.  
268

(4) Cased to ace, Size 2"


(5) Screen: Size 2", Length 5'

(6) Were any formations sealed against pollution?  
no.

If YES depth of formation \_\_\_\_\_

Why \_\_\_\_\_

Drillers Remarks: \_\_\_\_\_

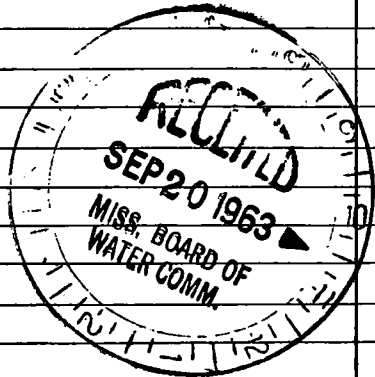

(Use Back Side)

Well No.

