

HANCOCK

WATER WELL DRILLERS LOG

K

K 2043

9-5-63

Date: 9-5, 1963, Driller: Sutter Well Works County Hancock

(Name)

(1) Owner of Land: A.E. Lincks (Name)
Matairie, La. (Address)

(2) Location: NW 1/4, SW 1/4, Sec. 40 T8S R14W
5 miles NW of Bay (distance) (direction) (Nearest Town)

(3) Topography: flat (Hilly) (Flat) (Level)


(4) Purpose of Well: domestic Home (Domestic Irrigation Municipal, Industrial, Other)

Table with 3 columns: Description & Color of Materials, Thickness Feet, Depth Feet. Rows include Clay, Sand, Clay, Sand with corresponding measurements.

Information upon completion of well:

- (1) Diameter 2 inches.
(2) Total Depth 162 feet.
(3) Water Level 1/2 feet below top of ground.
(4) Cased to 157' all, Size 2"
(5) Screen: Size 2", Length 5'
(6) Were any formations sealed against pollution? yes, no.

If YES depth of formation
Why
Drillers Remarks:

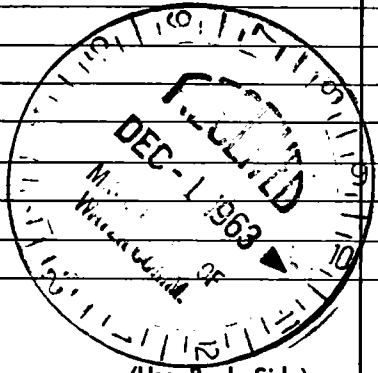

(Use Back Side)

Well No.

Handwritten notes at the top of the page, including the word "Distances" and various numbers and symbols.

Vertical handwritten text on the left side of the page.

Vertical handwritten text on the left side of the page.

Large handwritten notes in the center-right area, including the word "Distances" and various numbers and symbols.

Large handwritten notes at the bottom of the page, including the word "Distances" and various numbers and symbols.