

K 2046
9-27-63

WATER WELL DRILLERS LOG

K

Date: 9-27, 1963, Driller: Lutter Well Works County Hancock
(Name)

(1) Owner of Land: C. L. Hutcherson
(Name)
102 Meadow Lane - Weverland
(Address)

(2) Location: NE 1/4, SE 1/4, Sec. 40 T85R14, W
5 miles NW of Bay
(distance) (direction) (Nearest town)

(3) Topography: flat
(Hilly) (Flat) (Level)

(4) Purpose of Well: domestic home
(Domestic Irrigation
Municipal, Industrial, Other)

Description & Color of Materials Sand, Clay, Red Clay, Shell, etc.	Thick- ness Feet	Depth Feet
<u>Sandy clay</u>	<u>21</u>	<u>21</u>
<u>sand</u>	<u>25</u>	<u>46</u>
<u>Clay</u>	<u>17</u>	<u>63</u>
<u>sand</u>	<u>33</u>	<u>96</u>
<u>Clay</u>	<u>42</u>	<u>138</u>
<u>sand</u>	<u>34</u>	<u>172</u>

Information upon completion of well:

(1) Diameter 2 inches.

(2) Total Depth 172 feet.

(3) Water Level 1 feet below top of ground.

(4) Cased to app, Size 2"


(5) Screen: Size 2", Length 5'

(6) Were any formations sealed against pollution?
no

If YES depth of formation _____

Why _____

Drillers Remarks: _____

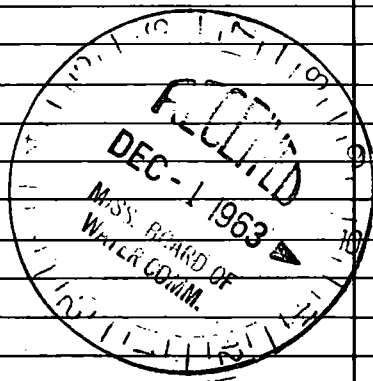

(Use Back Side)

Well No.

Handwritten text at the top left, possibly a name or title.

Handwritten text at the top center, possibly a date or reference number.

Handwritten number '82'.

Handwritten number '12-1'.

12	18
14	20
16	22
18	24
20	26
22	28
24	30
26	32
28	34
30	36

Handwritten notes or a list of items, possibly related to the table on the left.

Handwritten text in the middle right section, possibly a description or further notes.

Handwritten text at the bottom right, possibly a signature or a date.