

K 2047
10-2-63

WATER WELL DRILLERS LOG

K

Date: 10-2, 1963, Driller: Lutter Well Works County Hancock
(Name)

	Description & Color of Materials Sand, Clay, Red Clay, Shell, etc.	Thick- ness Feet	Depth Feet
(1) Owner of Land: <u>R. F. Mastayer, Jr.</u> (Name)	<u>Clay</u>	<u>16</u>	<u>16</u>
<u>1533 LaFite St., N.O. La</u> (Address)	<u>sand</u>	<u>21</u>	<u>37</u>
(2) Location: <u>NW 1/4, SE 1/4, Sec. 37 T8S R14W</u>	<u>Clay</u>	<u>51</u>	<u>48</u>
<u>1</u> miles <u>W</u> of <u>Bay St Louis</u> (distance) (direction) (Nearest Town)	<u>sand</u>	<u>12</u>	<u>100</u>
(3) Topography: <u>flat</u> (Hilly) (Flat) (Level)			
(4) Purpose of Well: <u>Domestic Home</u> (Domestic Irrigation Municipal, Industrial, Other)			


Information upon completion of well:

- (1) Diameter 1 1/4 inches.
- (2) Total Depth 100 feet.
- (3) Water Level 12 feet below top of ground.
- (4) Cased to 95, Size 1 1/4"
- (5) Screen: Size 1 1/4", Length 5'
- (6) Were any formations sealed against pollution?
no

If YES depth of formation _____

Why _____

Drillers Remarks: _____

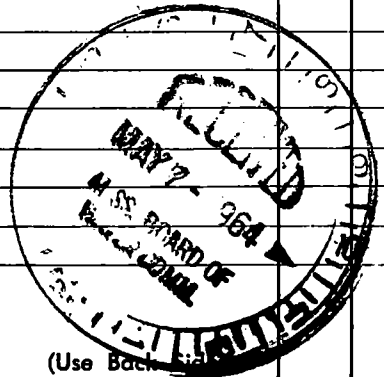

Well No. _____

(Use Back Side)

[Faint, illegible text, possibly bleed-through from the reverse side of the page]

